

Newton

Q 7

3-26-70

MISSISSIPPI  
 BOARD OF WATER COMMISSIONERS  
 416 North State Street  
 Jackson, Mississippi 39201

WATER WELL DRILLERS LOG

3-26-  
date well completed

1970 Wilkinson Drilling Co  
firm name

Newton  
county well located

LANDOWNER: Paul Williams

Hickory, Miss.

(mailing address)

description of formations encountered

from to

red clay	0	8
red sand	8	35
white sand	35	90
mixed sand & clay	90	175
blue clay	175	210
mixed clay & trash	210	390
sand	390	430

WELL LOCATION:

sec 32 T 5 N R 13 E

7 miles south of Hickory  
(distance) (direction) (nearest town)

WELL PURPOSE:

Home (home, irrigation, municipal, industrial)

WELL COMPLETION DATA:

- (1) diameter (inches) 4
- (2) total depth (feet) 430
- (3) static water level (feet) 63 below top of ground.

- (4) casing (material) Black (depth) 185

4 (size) if telescope see back.

- (5) screen (length) 90 (depth to top)

(size) (material)

- (6) pump (HP) 1/2 (yield gpm) 10

Electric (type power)

- (7) electric log (yes or no) no

no (organization running log)

- (8) how well bottom plugged Open


MAY 6 1970

DRILLERS REMARKS:

MISS. BD. OF WATER COMM.

If well telescopes please sketch and show depths.

GROUND LEVEL

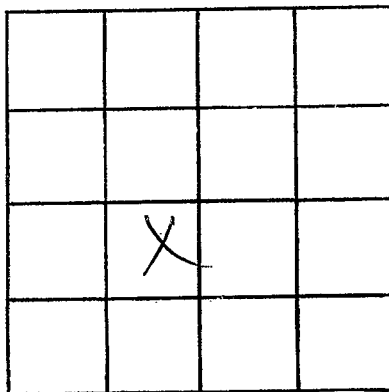

SECTION *32*

Please indicate well location X.

ADDITIONAL INFORMATION

If more than one screen,  
show locations of each on sketch.