

Newton
Q 8
3-27-70

MISSISSIPPI
 BOARD OF WATER COMMISSIONERS
 416 North State Street
 Jackson, Mississippi 39201

WATER WELL DRILLERS LOG

3-27- 1970 Williamson Drilling Co. Newton
 date well completed firm name county well located

LANDOWNER	description of formations encountered	from	to
<u>John Williams</u>	<u>top soil</u>	<u>0</u>	<u>2</u>
<u>Hickory Falls</u>	<u>red clay</u>	<u>2</u>	<u>6</u>
	<u>blue clay</u>	<u>6</u>	<u>30</u>
	<u>sand</u>	<u>30</u>	<u>170</u>
	<u>clay</u>	<u>170</u>	<u>105</u>
	<u>rock & clay</u>	<u>105</u>	<u>385</u>
	<u>sand</u>	<u>385</u>	<u>430</u>

(mailing address)

WELL LOCATION:

sec 32 T 5 N R 13 E
5 miles south of Hickory
 (distance) (direction) (nearest town)

WELL PURPOSE: Home
 (home, irrigation, municipal, industrial)

WELL COMPLETION DATA:

- (1) diameter (inches) 1 1/2
- (2) total depth (feet) 430
- (3) static water level (feet) 5' below top of ground.
- (4) casing black 178
 (material) (depth)
1 1/2 (size) If telescope see back.
- (5) screen no
 (length) (depth to top)
 (size) (material)
- (6) pump 3/4 12
 (HP) (yield gpm)
Electric
 (type power)
- (7) electric log no
 (yes or no)
no
 (organization running log)
- (8) how well bottom plugged Cap


MAY 6 1970

DRILLERS REMARKS:

MISS. BD. OF
 WATER COMMISSIONERS

If well telescopes please sketch and show depths.

GROUND LEVEL

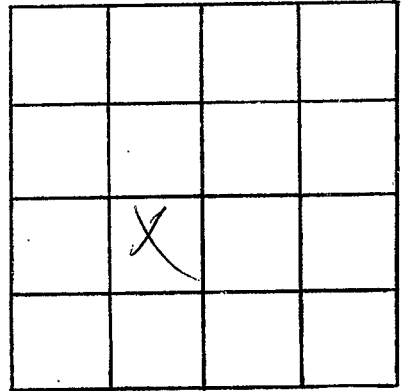

SECTION 32

Please indicate well location X.

ADDITIONAL INFORMATION

If more than one screen,
show locations of each on sketch.