

Newton  
Q 9  
4-1-70

MISSISSIPPI  
BOARD OF WATER COMMISSIONERS  
416 North State Street  
Jackson, Mississippi 39201

WATER WELL DRILLERS LOG

4-1-1970 date well completed  
William Duling Co. firm name  
Newton county well located

LANDOWNER: Leo Williams  
Heakary Miss.  
(mailing address)

description of formations encountered	from	to
red Clay	0	3
Blue Clay	3	25
sand	25	90
Clay	90	130
sand	130	180
Blue Clay	180	215
red Clay	215	385
sand	385	430

WELL LOCATION:  
sec 39 T. 5 S. R. 10 E  
7 miles south of Heakary  
(distance) (direction) (nearest town)

WELL PURPOSE: Home  
(home, irrigation, municipal, industrial)

- WELL COMPLETION DATA:
- (1) diameter (inches) 4
  - (2) total depth (feet) 430
  - (3) static water level (feet) 135 below top of ground.
  - (4) casing (material) Black (depth) 188
  - (size) 4 If telescope see back.
  - (5) screen (length) no (depth to top)
  - (size) 2 (material)
  - (6) pump 24 (HP) 12 (yield gpm)
  - (type power) Elec
  - (7) electric log no (yes or no)
  - no (organization running log)
  - (8) how well bottom plugged Open


MAY 6 1970

DRILLERS REMARKS:

MISS. Bd. OF  
WATER COMM.

If well telescopes please sketch and show depths.

GROUND LEVEL

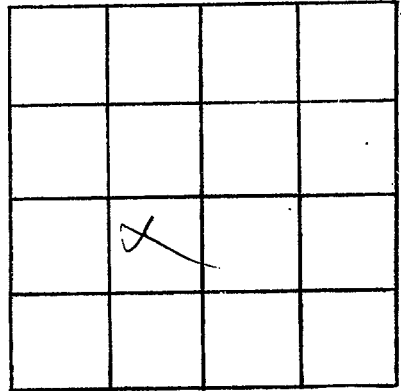

SECTION 32

Please indicate well location X.

ADDITIONAL INFORMATION

If more than one screen,  
show locations of each on sketch.