

NEWTON

Q 10

10-3-70

MISSISSIPPI BOARD OF WATER COMMISSIONER

416 North State Street

Jackson, Mississippi 39201

CODED

WATER WELL DRILLERS LOG

Oct 3 1970 J. L. Skelton Newton
date well completed firm name county well located

LANDOWNER: W. H. Buckley

Hickory

Miss

(mailing address)

description of formations encountered

from

to

Yellow Clay

0 19

Sand

19 29

Blue + Shell

99 119

Gray + shell

119 199

Blue

199 239

Gray Rocky

239 339

Sand

339 606

WELL LOCATION:

sec. 22 T-5 N R-13 E
S W
8 miles SE of Hickory
(distance) (direction) (nearest town)

WELL PURPOSE: Home
(home, irrigation, municipal, industrial)

WELL COMPLETION DATA:

(1) diameter (inches) 4"

(2) total depth (feet) 400

(3) static water level (feet) 85 below top of ground.

(4) casing Iron (material) (depth) 415

(size) If telescope see back.

(5) screen Open Hole (length) (depth to top)

(size) (material)

(6) pump 3/4 HP 600 (yield gpm)

elec. (type power)

(7) electric log (yes or no)

(organization running log)

(8) how well bottom plugged

DRILLERS REMARKS:



CODED

OCT 30 1970

MISS. BD. OF WATER COMM.

If well telescopes please sketch and show depths.

GROUND LEVEL

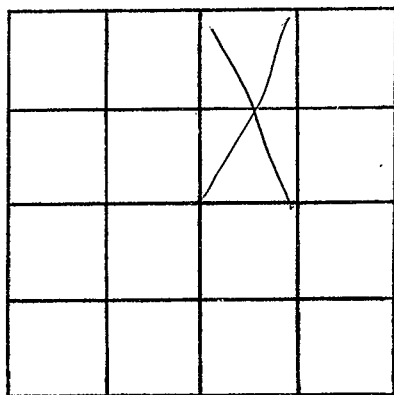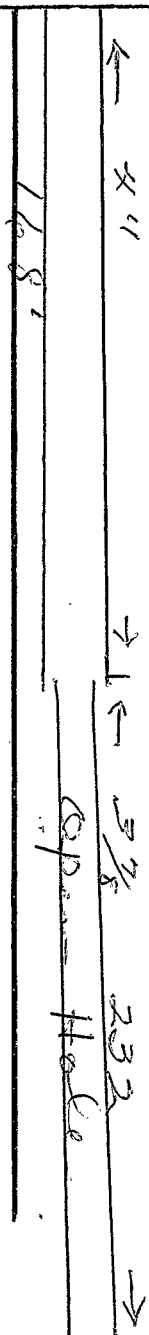

SECTION _____

Please indicate well location X.

ADDITIONAL INFORMATION

A series of horizontal lines for writing additional information.

If more than one screen, show locations of each on sketch.