

Newton  
Q13  
3-19-73

MISSISSIPPI  
BOARD OF WATER COMMISSIONERS  
416 North State Street  
Jackson, Mississippi 39201

WATER WELL DRILLERS LOG

**CODED**  
NEWTON

3.19.73  
date well completed


McDONALD + HILL  
firm name

NEWTON  
county well located

LANDOWNER:	description of formations encountered	from	to
J.M. HARRISON	CLAY	0	38
R#1 ENTERPRISE (mailing address)	SAND ST CLAY	30	110
WELL LOCATION: sec. 32 T 50 S R 13 E 7 miles SOUTH of Hickory (distance) (direction) (nearest town)	SHALE	110	165
WELL PURPOSE: HOME (home, irrigation, municipal, industrial)	SANDY	165	175
WELL COMPLETION DATA: (1) diameter (inches) 4" (2) total depth (feet) 400' (3) static water level (feet) 100' below top of ground. (4) casing PVC 184' (material) (depth) 4" (size) if telescope see back. (5) screen (length) (depth to top) (size) (material) (6) pump 12 (HP) 10 (yield gpm) 220 (type power) (7) electric log (yes or no) (organization running log) (8) how well bottom plugged OPEN	SHALE	175	195
	ROCK ST SHALE	195	230
	G SAND	230	245
	ROCK ST SAND	245	360
	SOFT SHALE	360	380
	COURSE SAND	380	400
DRILLERS REMARKS:			

If well telescopes please  
sketch and show depths.

GROUND LEVEL

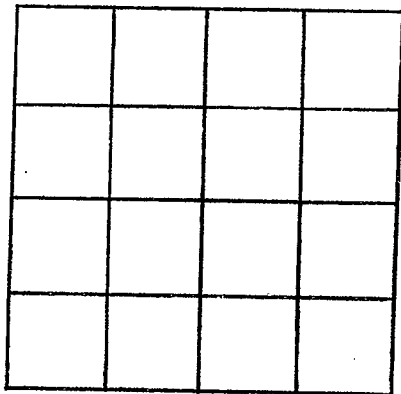

SECTION \_\_\_\_\_

Please indicate well location X.

ADDITIONAL INFORMATION

If more than one screen,  
show locations of each on sketch.