

NEWTON

Q 14

5-1-75

MISSISSIPPI BOARD OF WATER COMMISSIONERS
416 North State Street
Jackson, Mississippi 39201 CODED

WATER WELL DRILLERS LOG

5-1-75 19 McDONALD + HILL⁰⁰⁸ NEWTON
date well completed firm name county well located

LANDOWNER:
MRS W. M. MONROE
Hickory MISS
(mailing address)

description of formations encountered	from	to
CLAY SAND	0	10
SAND	10	35

WELL LOCATION:
sec. 6 T. 5^N R. 13^E
1/2 miles S EAST of Hickory
(distance) (direction) (nearest town)

SOFT SANDY SHALE	35	60
Shale	60	88
ROCK ST SHALE	88	110

WELL PURPOSE:
HOME
(home, irrigation, municipal, industrial)

GREEN SAND	110	125
------------	-----	-----

- WELL COMPLETION DATA:
- (1) diameter (inches) 4"
 - (2) total depth (feet) 280'
 - (3) static water level (feet) 16' below top of ground.
 - (4) casing PVC 88'
(material) (depth)
4" (size) if telescope see back.
 - (5) screen _____
(length) (depth to top)
(size) (material)
 - (6) pump 1/2 sub 10
(HP) (yield gpm)
ELECTRIC
(type power)
 - (7) electric log _____
(yes or no)
(organization running log)
 - (8) how well bottom plugged OPEN

ROCK ST SHALE	125	160
SHALE ST ROCK	160	260
SAND	260	280


DRILLERS REMARKS:

RECORDED
MAY - 6 1975

MISS. BD. OF WATER COMMISSIONERS

If well telescopes please sketch and show depths.

GROUND LEVEL

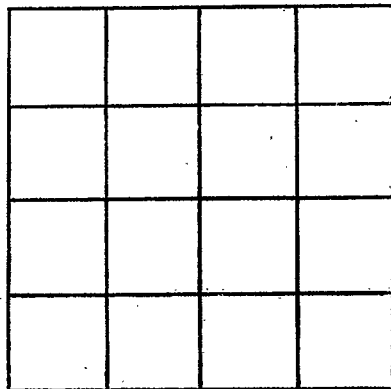

SECTION _____

Please indicate well location X.

ADDITIONAL INFORMATION

If more than one screen, show locations of each on sketch.