


NEWTON
15
11-12-74

MISSISSIPPI BOARD OF WATER COMMISSIONERS
 416 North State Street
 Jackson, Mississippi 39201

CODED


WATER WELL DRILLERS LOG

11-12-74 date well completed Williamson Drilling Co firm name Newton county well located

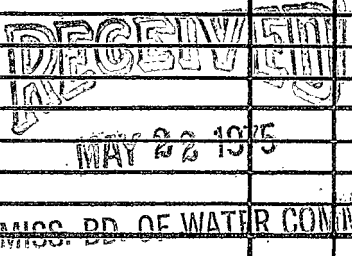LANDOWNER: <u>Sam Beutt Jr.</u>	description of formations encountered	from	to
<u>Box 96 A</u>			
<u>Hickory, Mo.</u> (mailing address)	<u>Blue Clay</u>	<u>3</u>	<u>18</u>
	<u>sand</u>	<u>28</u>	<u>47</u>
	<u>Blue Clay & rocks</u>	<u>27</u>	<u>165</u>
	<u>sand</u>	<u>265</u>	<u>305</u>
WELL LOCATION:			
sec. <u>7</u> T <u>5</u> N R <u>13</u> E			
<u>2</u> miles <u>south</u> of <u>Hickory</u>			
(distance) (direction) (nearest town)			
WELL PURPOSE: <u>domestic</u> (home, irrigation, municipal, industrial)			
WELL COMPLETION DATA:			
(1) diameter (inches) <u>4</u>			
(2) total depth (feet) <u>305</u>			
(3) static water level (feet) <u>15</u> ^{below} / _{above} top of ground.			
(4) casing <u>PVC</u> <u>80</u> (material) (depth)			
<u>4</u> If telescope see back. (size)			
(5) screen (length) (depth to top)			
(size) (material)			
(6) pump <u>1/2</u> <u>12</u> (HP) (yield gpm)			
<u>Elect.</u> (type power)			
(7) electric log <u>no</u> (yes or no)			
<u>no</u> (organization running log)			
(8) how well bottom plugged <u>Open</u>			
DRILLERS REMARKS:			
			

If well telescopes please sketch and show depths.

GROUND LEVEL

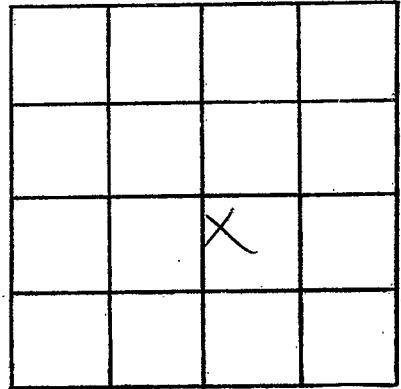

SECTION 7

Please indicate well location X.

ADDITIONAL INFORMATION

If more than one screen, show locations of each on sketch.