

① 16
 Newton
 5/20/75

MISSISSIPPI
 BOARD OF WATER COMMISSIONERS
 416 North State Street
 Jackson, Mississippi 39201

CODED

WATER WELL DRILLERS LOG

5.20.75
date well completed

McDONALD + HILL
firm name

NEWTON
county well located


LANDOWNER:	description of formations encountered	from	to
Hickory Res. Center	CLAY	0	18
Hickory (mailing address)	SAND CLAY	18	38
WELL LOCATION:	Light Sand Clay	38	58
sec. 3 T 5 N R 13 E	Gravelly SAND	50	78
2 miles SOUTH of Hickory (distance) (direction) (nearest town)	SAND	78	145
WELL PURPOSE: <input checked="" type="checkbox"/> home, <input type="checkbox"/> irrigation, <input type="checkbox"/> municipal, <input type="checkbox"/> industrial	SOFT SHALE	145	160
WELL COMPLETION DATA:	SAND ST. SHALE	160	170
(1) diameter (inches) 4"	SHALE	170	205
(2) total depth (feet) 260'	G SAND	205	240
(3) static water level (feet) 108' below top of ground.	SANDY	240	260
(4) casing PVC 176' (material) (depth) 4" (size) if telescope see back.			
(5) screen (length) (depth to top) (size) (material)			
(6) pump 1/2 sub 10 (HP) (yield gpm) ELECTRIC (type power)			
(7) electric log (yes or no) (organization running log)			
(8) how well bottom plugged OPEN			
DRILLERS REMARKS:			

RECEIVED
 MAY 27 1975

MISSISSIPPI
 BOARD OF WATER COMMISSIONERS

If well telescopes please
sketch and show depths.

GROUND LEVEL

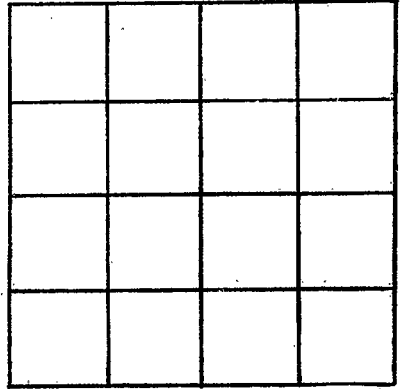

SECTION _____

Please indicate well location X.

ADDITIONAL INFORMATION

If more than one screen,
show locations of each on sketch.