

Newton
Q 17
7-1-75

MISSISSIPPI
BOARD OF WATER COMMISSIONERS
416 North State Street
Jackson, Mississippi 39201

CODED

WATER WELL DRILLERS LOG

7-1-75 19 McDonald Hill NEWTON
date well completed firm name county well located


LANDOWNER:	description of formations encountered	from	to
DELMER GOODEN	Clay	0	16
Hickory, Miss. (mailing address)	10 sand	16	72
WELL LOCATION: sec. 8 T 5 N R 13 E S W	Soft shale	72	88
2 miles Southeast of Hickory (distance) (direction) (nearest town)	sandy	88	95
WELL PURPOSE: STORM	shale	95	120
(home, irrigation, municipal, industrial)	CODED rock 57 shale	120	145
WELL COMPLETION DATA:	G sand	145	160
(1) diameter (inches) 4"	sand shale	160	180
(2) total depth (feet) 180'			
(3) static water level (feet) 30 below top of ground.			
(4) casing PVC 102' (material) (depth) 4" If telescope see back. (size)			
(5) screen (length) (depth to top) (size) (material)			
(6) pump 1/2 HP 6 (HP) (yield gpm) ELECTRIC (type power)			
(7) electric log (yes or no)			
(8) how well bottom plugged OPEN			
DRILLERS REMARKS:			

RECEIVED
JUL 11 1975

MISS. DE. OF WA. COM

If well telescopes please
sketch and show depths.

GROUND LEVEL

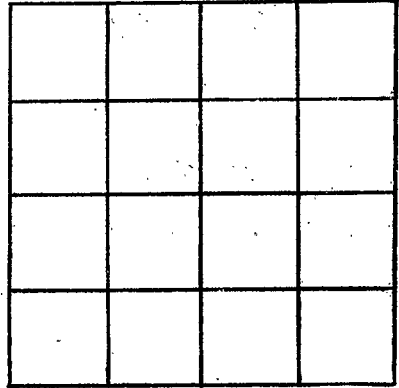

SECTION _____

Please indicate well location X.

ADDITIONAL INFORMATION

If more than one screen,
show locations of each on sketch.