

NEWTON  
 ⑤ 18  
 4-20-78

MISSISSIPPI  
 BOARD OF WATER COMMISSIONERS  
 416 North State Street  
 Jackson, Mississippi 39201

CODED

WATER WELL DRILLERS LOG

4-20-78 19 Williamson Drilling Co. Newton  
 date well completed firm name county well located

LANDOWNER: Miss Luine  
 Producers Inc.  
 Rt 1 Box 56  
 Hickory Ms.  
 (mailing address)

description of formations encountered	from	to
top soil	0	1
Red Clay	1	6
Blue Clay	6	70
sand	70	140
Blue Clay	140	225
rock & Clay	225	365
sand	365	432

WELL LOCATION:  
 sec 32 T 50 N R 13 E  
 S W  
 7 miles south of Hickory  
 (distance) (direction) (nearest town)

WELL PURPOSE: Hog Farm  
 (home, irrigation/municipal, industrial)

WELL COMPLETION DATA:

(1) diameter (inches) 4

(2) total depth (feet) 432

(3) static water level (feet) 70 below above top of ground.

(4) casing PVC 221 (material) (depth)  
 4 (size) If telescope see back.

(5) screen 30 402 (length) (depth to top)  
 10 PVC (size) (material)

(6) pump 5 75 (HP) (yield gpm)  
 Electric (type power)

(7) electric log no (yes or no)  
 no (organization running log)

(8) how well bottom plugged Cap

CODED


RECEIVED  
 MAY 24 1978

MISS. BD. OF WATER COMMISSIONERS

DRILLERS REMARKS:

If well telescopes please sketch and show depths.

GROUND LEVEL

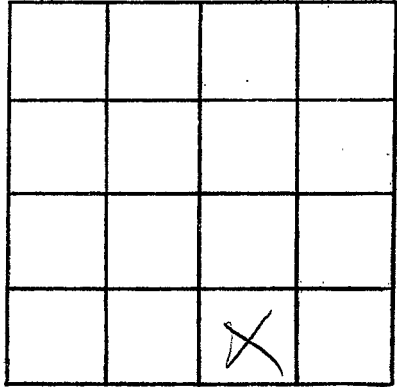

SECTION

32

Please indicate well location X.

ADDITIONAL INFORMATION

If more than one screen, show locations of each on sketch.