

Newton
Q 2002
5-3-80
5-3-80

MISSISSIPPI
 BOARD OF WATER COMMISSIONERS
 416 North State Street
 Jackson, Mississippi 39201

WATER WELL DRILLERS LOG

19 McDonald's Hill Newton
 date well completed firm name county well located

LANDOWNER:
Billy Binkley
Hickory
 (mailing address)

WELL LOCATION:
 sec. 10 T. 5 N R. 13 E
5 miles SW of Chukles
 (distance) (direction) (nearest town)

WELL PURPOSE: home
 (home, irrigation, municipal, industrial)

- WELL COMPLETION DATA:
- (1) diameter (inches) 4"
 - (2) total depth (feet) 260'
 - (3) static water level (feet) 55' below top of ground.
 - (4) casing PVC 75'
 (material) (depth)
4" if telescope see back.
 (size)
 - (5) screen _____
 (length) (depth to top)
 (size) (material)
 - (6) pump 1 600M
 (HP) (yield gpm)
E
 (type power)
 - (7) electric log _____
 (yes or no)
 (organization running log)
 - (8) how well bottom plugged open


description of formations encountered	from	to
<u>sand & clay</u>	<u>0</u>	<u>45</u>
<u>sandy shale</u>	<u>45</u>	<u>70</u>
<u>shale</u>	<u>70</u>	<u>90</u>
<u>Rock & shells</u>	<u>90</u>	<u>110</u>
<u>green sand</u>	<u>110</u>	<u>122</u>
<u>shale & rock</u>	<u>122</u>	<u>245</u>
<u>sand</u>	<u>245</u>	<u>260</u>

DEPT. OF NATURAL RESOURCES
 BUREAU OF LAND & WATER RESOURCES
 MAY 14 1980
 RECEIVED

DRILLERS REMARKS:

If well telescopes please sketch and show depths.

GROUND LEVEL

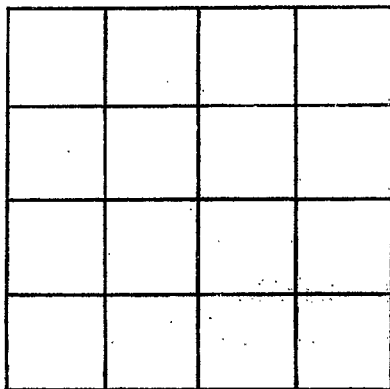

SECTION _____

Please indicate well location X.

ADDITIONAL INFORMATION

If more than one screen, show locations of each on sketch.