

MISSISSIPPI DEPARTMENT OF NATURAL RESOURCES

Bureau of Land and Water Resources

Southport Mall

P.O. Box 10631

Jackson, Mississippi 39209

WATER WELL DRILLERS LOG

Newton  
D 2004  
6/9/81

6-9-81  
date well completed

McDonald & Hill  
firm name


Newton  
county well located

LANDOWNER:	description of formations encountered	from	to
<u>Saman Parks</u>			
<u>RT / Box 12, Centerville</u> (mailing address)	<u>shale</u>	<u>10</u>	<u>30</u>
WELL LOCATION:	<u>sand &amp; s<sup>t</sup> clay</u>	<u>30</u>	<u>150</u>
sec <u>27</u> T <u>5</u> N R <u>13</u> E	<u>sandy shale</u>	<u>150</u>	<u>170</u>
<u>12</u> miles <u>SE</u> of <u>Hickory</u>	<u>shale</u>	<u>170</u>	<u>190</u>
(distance) (direction) (nearest town)	<u>Rock &amp; shell</u>	<u>190</u>	<u>210</u>
WELL PURPOSE: <u>home</u> (home, irrigation, municipal, industrial)	<u>green sand &amp; sandy shale</u>	<u>210</u>	<u>225</u>
WELL COMPLETION DATA:	<u>shale &amp; Rock</u>	<u>225</u>	<u>350</u>
(1) diameter (inches) <u>4"</u>	<u>shale st sand</u>	<u>350</u>	<u>370</u>
(2) total depth (feet) <u>420'</u>	<u>course sand</u>	<u>370</u>	<u>400</u>
(3) static water level (feet) <u>105'</u> below above top of ground.			
(4) casing <u>PVC</u> <u>180'</u> (material) (depth)			
<u>4"</u> (size) if telescope see back.			
(5) screen _____ (length) (depth to top)			
(size) (material)			
(6) pump <u>1/2</u> <u>8000</u> (HP) (y/eld gpm)			
<u>F</u> (type power)			
(7) electric log _____ (yes or no)			
(organization running log)			
(8) how well bottom plugged <u>open</u>			

DRILLERS REMARKS:

If well telescopes please  
sketch and show depths.

GROUND LEVEL

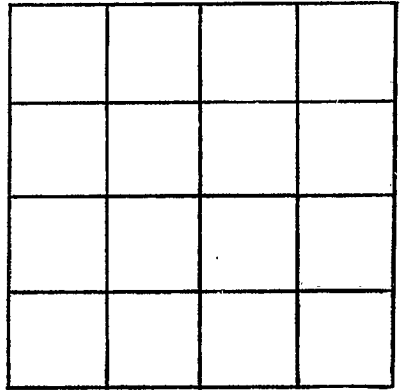

SECTION \_\_\_\_\_

Please indicate well location X.

ADDITIONAL INFORMATION

If more than one screen,  
show locations of each on sketch.