

MISSISSIPPI DEPARTMENT OF NATURAL RESOURCES

Bureau of Land and Water Resources

Southport Mall

P.O. Box 10631

Jackson, Mississippi 39209

WATER WELL DRILLERS LOG

NEWTON
 Q 2005
 11-4-81

11-4-81 date well completed McDonald & Hill firm name Newton county well located

LANDOWNER:
 J. B. Williams
 P.O. # 1 Box 70 Hickory
 (mailing address)

WELL LOCATION:
 sec. 30 T. 50 N. R. 13 E.
 8 1/2 miles S of Hickory
 (distance) (direction) (nearest town)

WELL PURPOSE: home
 (home, irrigation, municipal, industrial)

WELL COMPLETION DATA:

- (1) diameter (inches) 2 1/2"
- (2) total depth (feet) 300'
- (3) static water level (feet) 140' below top of ground.
- (4) casing PVC, 230'
 (material) (depth)
4" if telescope see back.
 (size)
- (5) screen _____
 (length) (depth to top)
 (size) (material)
- (6) pump 1 80.0W
 (HP) (yrd gpm)
 (type power)
- (7) electric log _____
 (yes or no)
 (organization running log)
- (8) how well bottom plugged open

description of formations encountered	from	to
clay & sand	0	25
sandy shale	25	45
shale & sand	45	130
shale	130	160
sand	160	185
sandy shale	185	220
shale	220	243
rock & shells	243	265
green sand & sandy shale	265	290
rock & shale	290	300

DEPT. OF NATURAL RESOURCES
 BUREAU OF LAND & WATER RESOURCES


NOV 9 - 1981

RECEIVED

DRILLERS REMARKS:

If well telescopes please sketch and show depths.

GROUND LEVEL

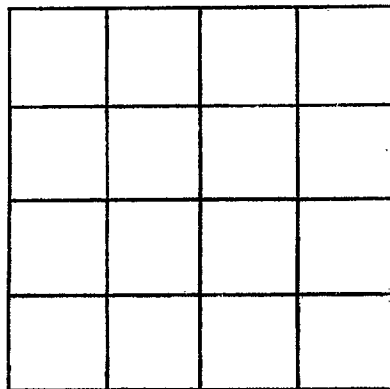

SECTION _____

Please indicate well location X.

ADDITIONAL INFORMATION

If more than one screen, show locations of each on sketch.