

Newton
Q 2006
12-2-81

MISSISSIPPI
BOARD OF WATER COMMISSIONERS
416 North State Street
Jackson, Mississippi 39201

WATER WELL DRILLERS LOG

*Newton
Clarks*

12-2-81 date well completed
1981 McDonald & Hill firm name
Newton Clarks county well located

LANDOWNER: *Eunice Little*
Hickory, ms
(mailing address)

WELL LOCATION:
sec. *14* T. *5* N. R. *13* E.
3 miles *S. East* of *Hickory*
(distance) (direction) (nearest town)

WELL PURPOSE: *home*
(home, irrigation, municipal, industrial)

- WELL COMPLETION DATA:
- (1) diameter (inches) *4*
 - (2) total depth (feet) *260*
 - (3) static water level (feet) *26* below top of ground.
 - (4) casing *4" Pvc 80'*
(material) (depth)
(size) if telescope see back.
 - (5) screen _____
(length) (depth to top)
(size) (material)
 - (6) pump *1/2* *8*
(HP) (yield gpm)
(type power)
 - (7) electric log _____
(yes or no)
(organization running log)
 - (8) how well bottom plugged *Open*

DRILLERS REMARKS:

description of formations encountered	from	to
<i>Clay</i>	<i>0</i>	<i>18</i>
<i>Shale st sand</i>	<i>18</i>	<i>44</i>
<i>sandy shale sts</i>	<i>44</i>	<i>65</i>
<i>shale</i>	<i>65</i>	<i>90</i>
<i>Green sand & Rock</i>	<i>90</i>	<i>125</i>
<i>Rock & shale</i>	<i>125</i>	<i>245</i>
<i>Coarse sand</i>	<i>245</i>	<i>260</i>


DEPT. OF NATURAL RESOURCES
BUREAU OF LAND & WATER RESOURCES

DEC-8 1981

RECEIVED

If well telescopes please sketch and show depths.

GROUND LEVEL

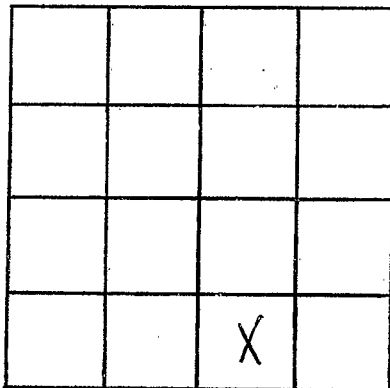

SECTION 18

Please indicate well location X.

ADDITIONAL INFORMATION

If more than one screen, show locations of each on sketch.