

MISSISSIPPI DEPARTMENT OF NATURAL RESOURCES

Bureau of Land and Water Resources

Southport Mall

P.O. Box 10631

Jackson, Mississippi 39209

WATER WELL DRILLERS LOG

Newton
Q 2007

4-21-82
date well completed

McDonald's Well
firm name

Newton
county well located

LANDOWNER:	description of formations encountered	from	to
Dwelle Parks Rt # Enterprise (mailing address)			
WELL LOCATION:	sand	90	120
sec. <u>34</u> T <u>S</u> N R. <u>13</u> E W	shale	120	140
<u>10</u> miles <u>SE</u> of <u>Wickover</u>	sandy shale	140	150
(distance) (direction) (nearest town)	shale	150	171
WELL PURPOSE: <u>Home</u>	Rock & shells	171	195
(home, irrigation, municipal, industrial)	green sand & sandy shale	195	210
WELL COMPLETION DATA:	shale & rock	210	340
(1) diameter (inches) <u>4"</u>	shale & sand	340	360
(2) total depth (feet) <u>380'</u>	course sand	360	380
(3) static water level (feet) <u>85'</u> below above top of ground.			
(4) casing <u>PVC</u> <u>1100'</u> (material) (depth)			
<u>4"</u> (size) if telescope see back.			
(5) screen (length) (depth to top)			
(size) (material)			
(6) pump <u>1/2</u> <u>890M</u> (HP) (yield gpm)			
(type power)			
(7) electric log (yes or no)			
(organization running log)			
(8) how well bottom plugged <u>open</u>			
DRILLERS REMARKS:			


DEPT. OF NATURAL RESOURCES
BUREAU OF LAND & WATER RESOURCES

APR 27 1982

RECEIVED

If well telescopes please sketch and show depths.

GROUND LEVEL

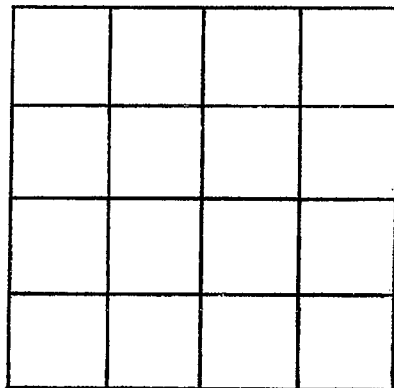

SECTION _____

Please indicate well location X.

ADDITIONAL INFORMATION

If more than one screen, show locations of each on sketch.