

MISSISSIPPI DEPARTMENT OF NATURAL RESOURCES

Bureau of Land and Water Resources

Southport Mall

P.O. Box 10631

Jackson, Mississippi 39209

WATER WELL DRILLERS LOG

| |
|--------|
| Newton |
| Q |
| 2008 |

7-30-82, 19 McDonald & Hill Newton
 date well completed firm name county well located


| LANDOWNER: | description of formations encountered | from | to |
|--|---------------------------------------|------|-----|
| Mrs Robert Cleveland | | | |
| Rt # 1 Hickory (mailing address) | sandy shale | 25 | 40 |
| WELL LOCATION: | shale | 40 | 70 |
| sec. 6 T. 5 N R. 13 E, 1/2 miles SE of Hickory (distance) (direction) (nearest town) | rock & shells | 70 | 100 |
| WELL PURPOSE: none (home, irrigation, municipal, industrial) | green sand | 100 | 110 |
| WELL COMPLETION DATA: | Rock & shale | 110 | 215 |
| (1) diameter (inches) 4" | sandy shale | 215 | 225 |
| (2) total depth (feet) 260' | sand | 225 | 260 |
| (3) static water level (feet) 30 below above top of ground. | | | |
| (4) casing PVC 67' (material) (depth) 4" (size) if telescope see back. | | | |
| (5) screen (length) (depth to top) (size) (material) | | | |
| (6) pump 1/2 HP 80 GPM (HP) (yield gpm) K (type power) | | | |
| (7) electric log (yes or no) (organization running log) | | | |
| (8) how well bottom plugged Open | | | |
| DRILLERS REMARKS: | | | |

DEPT. OF NATURAL RESOURCES
 BUREAU OF LAND & WATER RESOURCES

AUG 9 1982
 RECEIVED

If well telescopes please
sketch and show depths.

GROUND LEVEL

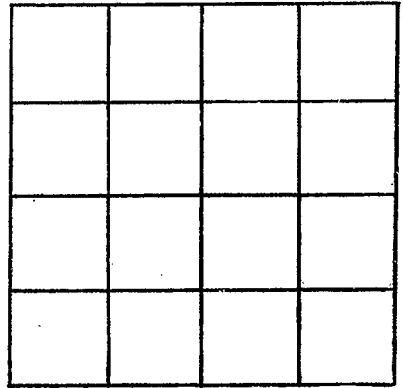

SECTION _____

Please indicate well location X.

ADDITIONAL INFORMATION

If more than one screen,
show locations of each on sketch.