

MISSISSIPPI DEPARTMENT OF NATURAL RESOURCES

Bureau of Land and Water Resources

Southport Mall

P.O. Box 10631

Jackson, Mississippi 39209

WATER WELL DRILLERS LOG

Newton
Q
2011

8-9-84

McDonald & Skill

Newton

date well completed

firm name

county well located

LANDOWNER:	description of formations encountered	from	to
Robert Daiseley	clay & sand	0	25
Rt #1 Chunks (mailing address)	sandy shale	25	35
WELL LOCATION:	shale	35	55
sec. <u>1</u> T. <u>S</u> N. R. <u>13</u> E. S. W.	Rock & shells	55	85
<u>2</u> miles <u>S</u> of <u>Chunks</u>	shale & rock	85	140
(distance) (direction) (nearest town)	sand	140	150
WELL PURPOSE: <u>home</u>	Rock & shale	150	170
(home, irrigation, municipal, industrial)	shale	170	175
WELL COMPLETION DATA:	Rock & shale	175	205
(1) diameter (inches) <u>4"</u>	shale & sand	205	220
(2) total depth (feet) <u>240'</u>	course sand	220	240
(3) static water level (feet) <u>100'</u> below above top of ground.			
(4) casing <u>PVC</u> , <u>175'</u> (material) (depth)			
<u>4"</u> (size) if telescope see back.			
(5) screen (length) (depth to top)			
(size) (material)			
(6) pump <u>3/4</u> <u>90.0M</u> (HR) (yield gpm)			
<u>F</u> (type power)			
(7) electric log (yes or no)			
(organization running log)			
(8) how well bottom plugged <u>Open</u>			
DRILLERS REMARKS:			


DEPT. OF NATURAL RESOURCES
 BUREAU OF LAND & WATER RESOURCES

AUG 15 1984

RECEIVED

If well telescopes please sketch and show depths.

GROUND LEVEL

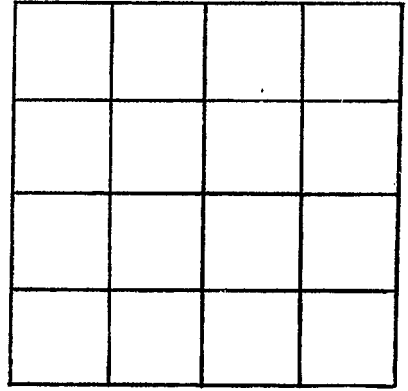

SECTION _____

Please indicate well location X.

ADDITIONAL INFORMATION

If more than one screen,
show locations of each on sketch.