

MISSISSIPPI DEPARTMENT OF NATURAL RESOURCES

Bureau of Land and Water Resources

Southport Mall

P.O. Box 10631

Jackson, Mississippi 39209

WATER WELL DRILLERS LOG

Newton
 2012
 5-26-86
~~5-26-86~~

McDONALD HILL

NEWTON

date well completed

firm name

county well located

LANDOWNER:	description of formations encountered	from	to
Buddy SNOWDEN ENTERPRISE MS (mailing address)			
	SHALE	35	70
	SAND	70	110
	SANDy	110	140
	SHALE	140	210
	Rock & shale	210	230
	GREEN SAND	230	245
	SHALE ST ROCK	245	360
	SANDy	360	380
	SAND	380	420
WELL LOCATION: sec. <u>36</u> T <u>5</u> N R <u>13</u> E S W			
<u>7</u> miles <u>WEST</u> of <u>Enterprise</u> (distance) (direction) (nearest town)			
WELL PURPOSE: <u>Home</u> (home, irrigation, municipal, industrial)			
WELL COMPLETION DATA:			
(1) diameter (inches) <u>4"</u>			
(2) total depth (feet) <u>420'</u>			
(3) static water level (feet) <u>130'</u> below top of ground.			
(4) casing <u>PVC 202'</u> (material) (depth) <u>4"</u> (size) if telescope see back.			
(5) screen _____ (length) (depth to top) _____ (size) (material)			
(6) pump <u>12</u> (HP) (yield gpm) _____ (type power)			
(7) electric log _____ (yes or no) _____ (organization running log)			
(8) how well bottom plugged <u>OPEN</u>			


RECEIVED
 JUN 04 1986

Department of Natural Resources
 Bureau of Land & Water Resources

DRILLERS REMARKS:

If well telescopes please sketch and show depths.

GROUND LEVEL

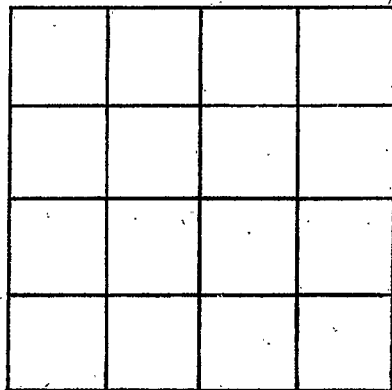

SECTION _____

Please indicate well location X.

ADDITIONAL INFORMATION

If more than one screen, show locations of each on sketch.