

Newton

Q

2013

Bureau of Land and Water Resources  
 Southport Mall  
 P.O. Box 10631  
 Jackson, Mississippi 39209  
**WATER WELL DRILLERS LOG**

6-17-86 19 McDonald + Hill NEWTON  
 date well completed firm name county well located


AND OWNER: EVERETT KIMBRIEL  
Chunky MS  
 (mailing address)

description of formations encountered	from	to
CLAY + SAND	0	14
SAND	14	72
SHALE	72	110
SHALE STROCK	110	260
FINE SAND ST SHALE	260	290
COARSE SAND	290	316

WELL LOCATION:  
 sec 11 T 5 N R 13 E  
3 miles SOUTH of CHUNKY  
 (distance) (direction) (nearest town)

WELL PURPOSE: HOME  
 (home, irrigation, municipal, industrial)

- WELL COMPLETION DATA:
- diameter (inches) 4"
  - total depth (feet) 316'
  - static water level (feet) 129' below top of ground.
  - casing PVC, 301',  
 (material) (depth)  
4" If telescope see back.  
 (size)
  - screen 15', 301'  
 (length) (depth to top)  
4" (size) PVC (material)
  - pump \_\_\_\_\_ (HP) \_\_\_\_\_ (yield gpm)  
 (type power)
  - electric log \_\_\_\_\_ (yes or no)  
 (organization running log)
  - how well bottom plugged VALUE

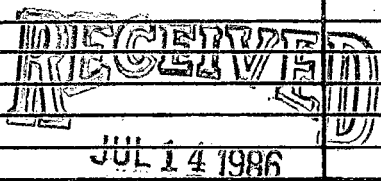

Department of Natural Resources  
 Bureau of Land & Water Resources

DRILLERS REMARKS:

