

MISSISSIPPI
BOARD OF WATER COMMISSIONERS
 416 North State Street
 Jackson, Mississippi 39201
 G.W. - 8661
WATER WELL DRILLERS LOG

CODED

OK TIBBEHA
 All
 10/24/80
 Log # T3

24 October 19 80 Herndon Well & Supply, Inc. Oktibbeha
 date well completed firm name county well located

LANDOWNER: Double Springs Water Association, Route 1	description of formations encountered	from	to
Maben, MS 39750 (mailing address)	Surface casing	0	18
	Red Clay	10	30
	Blue clay	30	60
	Black Shale	60	90
	Black shale	90	180
	Blue gumbo	180	330
	Dark clay & blue rock	330	700
	Sandy blue rock	700	760
	Blue rock	760	1300
	Sandy	1300	1330
	Streaked sand & gumbo	1330	1560
	Blue shale	1560	1590
	Streaked sand & gumbo	1590	1710
	Gumbo	1710	1830
	Streaked sand & gumbo	1830	1860
	Gumbo	1860	1920
	Gumbo & sand	1920	1950
	Sand	1950	2040
	Streaked sand & gumbo	2040	2100
	Sand	2100	2160
	Gumbo, pink	2160	2170

CODED

DEPT. OF NATURAL RESOURCES
 BUREAU OF LAND & WATER RESOURCES

OCT 29 1980
RECEIVED

sec. 8 T 19 N R 12 E W
 3 miles East of Mathiston
 (distance) (direction) (nearest town)

WELL LOCATION:
 Wells are located (distance) (direction) of (nearest town)

WELL PURPOSE: Municipal
 (home, irrigation, municipal, industrial)

WELL COMPLETION DATA:

(1) diameter (inches) 10 1/2

(2) total depth (feet) 2178

(3) static water level (feet) 318 below top of ground. above

(4) casing Steel, 1553 (material), (depth)
 10" If telescope see back. (size)

(5) screen 60' 1997 (length), (depth to top)
 6" Stainless Pipe base (size), (material)

(6) pump 50 (HP) 259 (yield gpm)
 Electric (type power)

(7) electric log UYes (yes or no)
 M.G.S. (organization running log)

(8) how well bottom plugged B.W. Valve

DRILLERS REMARKS:

If well telescopes please sketch and show depths.

GROUND LEVEL

10" T+c

Top LAP 1491

Bottom Casing 1553

506' Blank

30' Screen

60' Blank

2027


30' Screen

2087

61' Blank

2117

B.W. Valve 2178

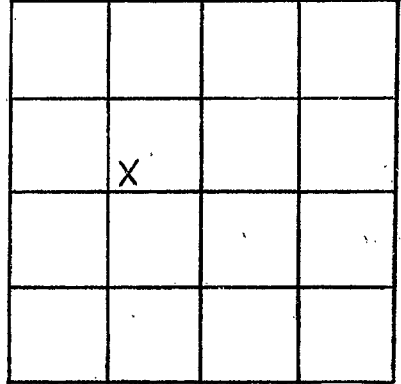

SECTION 8

Please indicate well location X.

ADDITIONAL INFORMATION

If more than one screen, show locations of each on sketch.