

OKT.

MISSISSIPPI BOARD OF WATER COMMISSIONERS

B  
8-62

WATER WELL DRILLERS LOG

Date: August, 1962, Driller: Case Drilling Co County Yazoo  
(Name)

GRIMES

(1) Owner of Land: no names  
R F D Starkman Miss  
(Name)  
(Address)

(2) Location: 1/4, 1/4, Sec. 19 T19R13  
10 miles west, of Starkville  
(distance) (direction) (Nearest Town)

(3) Topography: X  
(Hilly) (Flat) (Level)

(4) Purpose of Well: Romiter  
(Domestic Irrigation  
Municipal, Industrial, Other)

Information upon completion of well:

(1) Diameter 4 inches.

(2) Total Depth 1060 feet.

(3) Water Level 80 feet below top of ground.

(4) Cased to 120, Size 4

(5) Screen: Size 2, Length 84

(6) Were any formations sealed against pollution?


X yes, \_\_\_\_\_ no.

If YES depth of formation 120

Why Surface water & blue shale

Drillers Remarks:

Description & Color of Materials Sand, Clay, Red Clay, Shell, etc.	Thick- ness- Feet	Depth Feet
<u>Top soil</u>	<u>10</u>	<u>10</u>
<u>Blue shale</u>	<u>110</u>	<u>120</u>
<u>Hard redma clack</u>	<u>730</u>	<u>850</u>
<u>Hot sand, stone bed</u>	<u>110</u>	<u>110</u>
		<u>1060</u>

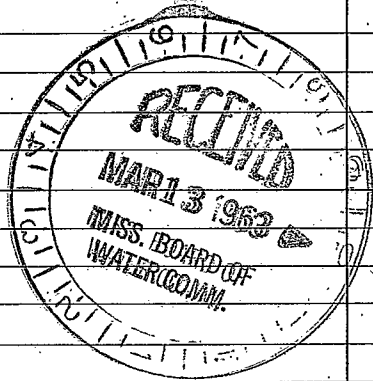

(Use Back Side)

Well No.

100

100

