

Oktibbeha
 B13
 1964
 M.G.S.

MISSISSIPPI
 BOARD OF WATER COMMISSIONERS
 416 North State Street
 Jackson, Mississippi 39201

CODED

WATER WELL DRILLERS LOG

1964 date well completed 19 T.M. PARKS Drlg Co firm name Oktibbeha county well located

LANDOWNER: Adaton WATER

description of fomations encountered

from to

ASSN.
 STARKSVILLE, Miss.
 (mailing address)

CLAYS w/color	0	200
sandy w/c. clays	200	275
CHALK w/CLAYS, SANDY	275	380
CHALK, HARD	380	900
HARD w/STRONG SHALE	900	1180
+ ROCK w/sand		
HARD, CHALK w/SHALE	1180	1390
SPAD, SHALE	1390	1480
Gumbo + Clays Pal -	1480	1570
GRAVEL w/SPAD	1570	1550
CLAY, w/Gumbo + sand	1550	1570
G. GRAVEL, SAND - SHALE	1570	1645

WELL LOCATION:

sec 29 T 19 N R 13 E
 4 miles west of STARKSVILLE
 (distance) (direction) (nearest town)

WELL PURPOSE:
 (home, irrigation, municipal, industrial)

WELL COMPLETION DATA:

- (1) diameter (inches) 6"
- (2) total depth (feet) 524
- (3) static water level (feet) 87' below top of ground.
- (4) casing Steel 524' (material) (depth)
 2 1/2" if telescope see back. (size)
- (5) screen 30' 1615' (length) (depth to top)
 2 1/2" Stainless (size) (material)
- (6) pump 7 1/2 HP 100 (HP) (yield gpm)
 3 Phase (type power)
- (7) electric log MS - Yes (yes or no)
 MS (organization running log)
- (8) how well bottom plugged BP

TD 1645

CODED

APR 17 1964

MISS. RD. OF WATER COMM.

DRILLERS REMARKS:


⑧

If well telescopes please sketch and show depths.


B/3

GROUND LEVEL

524-8'

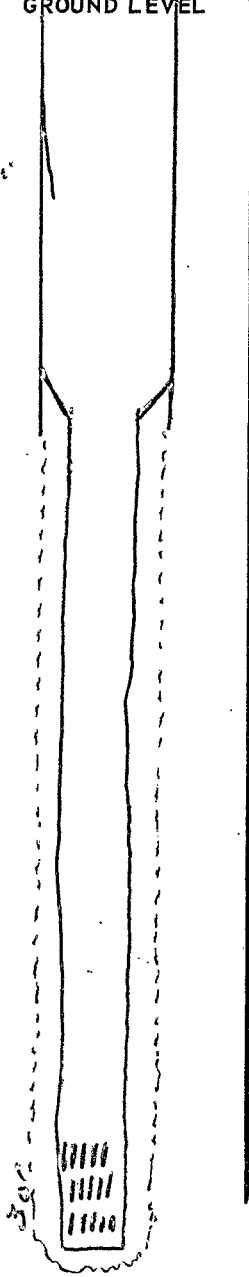

If more than one screen, show locations of each on sketch.

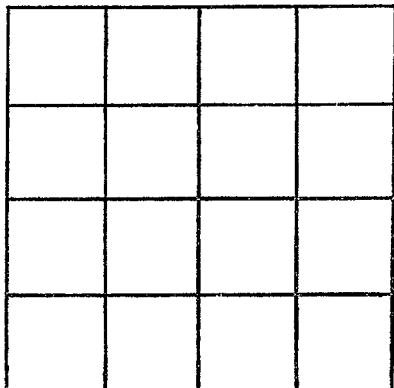

SECTION 29

Please indicate well location X.

ADDITIONAL INFORMATION

Lined area for recording additional information, consisting of approximately 18 horizontal lines.