

OKTIBBEHA
B 14
5-28-71

MISSISSIPPI
 BOARD OF WATER COMMISSIONERS
 416 North State Street
 Jackson, Mississippi 39201

CODED

WATER WELL DRILLERS LOG

May 28 19 71 Norman Echols Attala
 (date well completed) firm name county well located

LANDOWNER:
Thomas Christopher
Starbuck, Miss
 (mailing address)

description of formations encountered	from	to
<u>Black Clay</u>	<u>0</u>	<u>180</u>
<u>Crackly</u>	<u>180</u>	<u>925</u>
<u>Sand</u>	<u>925</u>	<u>1025</u>

WELL LOCATION:
 sec. 19 T. 19 S. R. 13 E.
9 miles West of Starbuck
 (distance) (direction) (nearest town)

WELL PURPOSE:
 (home, irrigation, municipal, industrial)

- WELL COMPLETION DATA:
- diameter (inches) 4"
 - total depth (feet) 1025
 - static water level (feet) 170 ⁹ below / ₁ above top of ground.
 - casing 200 4"
 (material) (depth)
 (size) If telescope see back.
 - screen 0
 (length) (depth to top)
 (size) (material)
 - pump 1 4 G P.M.
 (HP) (yield gpm)
Elect Rod pump
 (type power)
 - electric log (yes or no) _____
 (organization running log)
 - how well bottom plugged _____

CODED


JUN 9 1971

MISS. BD. OF
 WATER COMMISSIONERS

DRILLERS REMARKS:

If well telescopes please
sketch and show depths.

GROUND LEVEL

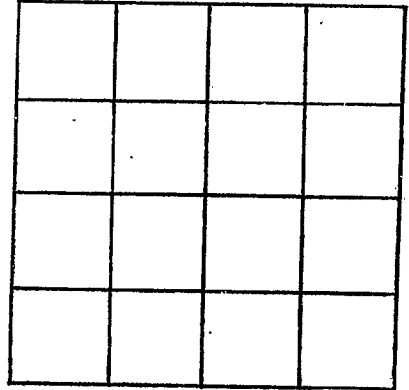

SECTION _____

Please indicate well location X.

ADDITIONAL INFORMATION

If more than one screen,
show locations of each on sketch.