

**OK Tibbaha**  
**B 17**  
**1-72**

MISSISSIPPI  
 BOARD OF WATER COMMISSIONERS  
 416 North State Street  
 Jackson, Mississippi 39201

**CODED**

**WATER WELL DRILLERS LOG**

*Jan* 19 *72* *Norman C. Cook* *OK Tibbaha*  
 date well completed firm name county well located

LANDOWNER: *Gordon Howell*  
*Starbuck, Miss*  
 (mailing address)

description of formations encountered	from	to
<i>top Soil, Black clay</i>	<i>0</i>	<i>30</i>
<i>Clay</i>	<i>30</i>	<i>760</i>
<i>Sand, Rock &amp; some clay</i>	<i>760</i>	<i>940</i>

WELL LOCATION:  
 sec *14* T *19* N R *13* E  
 S W  
*6* miles *N.W.* of *Starbuck*  
 (distance) (direction) (nearest town)

WELL PURPOSE:  
 (home, irrigation, municipal, industrial)

- WELL COMPLETION DATA:
- (1) diameter (inches) *5"*
  - (2) total depth (feet) *940*
  - (3) static water level (feet) \_\_\_\_\_ below above top of ground.
  - (4) casing ~~Top Casing~~ (material) (depth) *H2' 5" Casing Top* (size) if telescope see back.
  - (5) screen (length) (depth to top) (size) (material)
  - (6) pump *34* (HP) *10* (yield gpm) *Electric* (type power)
  - (7) electric log (yes or no)
  - (organization running log)
  - (8) how well bottom plugged

**CODED**


MAR 10 1972

DRILLERS REMARKS:  
*400' 9" Bottom Casing*

MISS. BD. OF  
 WATER COMM.

If well telescopes please sketch and show depths.

GROUND LEVEL

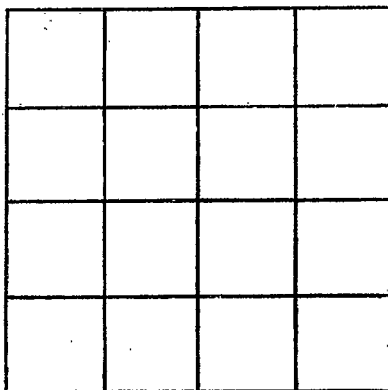

SECTION \_\_\_\_\_

Please indicate well location X.

ADDITIONAL INFORMATION

If more than one screen,  
show locations of each on sketch.