

MISSISSIPPI BOARD OF WATER COMMISSIONERS  
416 North State Street  
Jackson, Mississippi 39201

**CODED**

WATER WELL DRILLERS LOG

OKTIBBEHA  
C 23  
11-27-70

Nov 27 1970 Norman Echols OKTIBBEHA  
date well completed firm name county well located

LANDOWNER: James Moore  
R.F.D. - 1  
Starbelle, Miss.  
(mailing address)

description of formations encountered	from	to
<u>top soil</u>	<u>0</u>	<u>18</u>
<u>white sand</u>	<u>15</u>	<u>660</u>
<u>rock &amp; sand</u>	<u>660</u>	<u>810</u>

WELL LOCATION:  
sec. 7 T 19 N R. 14 E  
5 miles N.W. of Starbelle  
(distance) (direction) (nearest town)

WELL PURPOSE: Home  
(home, irrigation, municipal, industrial)

- WELL COMPLETION DATA:
- (1) diameter (inches) 4"
  - (2) total depth (feet) 810
  - (3) static water level (feet) 65' below above top of ground.
  - (4) casing 9 1/4" over 2"  
(material) (depth)  
2' if telescope see back.  
(size)
  - (5) screen 40' Bottom of well  
(length) (depth to top)  
2 1/2" Stainless Steel  
(size) (material)
  - (6) pump 1 10  
(HP) (yield gpm)  
Electric  
(type power)
  - (7) electric log Yes  
(yes or no)  
W.S.A.S.  
(organization running log)
  - (8) how well bottom plugged

**NOTE**

**CODED**

9 1/4"

Seal Seal 7

9" pipe

40' Screen

810 Bottom Well


**DEC 30 1970**

DRILLERS REMARKS:  
Well was drilled with air & good clear

MISS. BD. OF WATER COMMISSIONERS

If well telescopes please sketch and show depths.

GROUND LEVEL

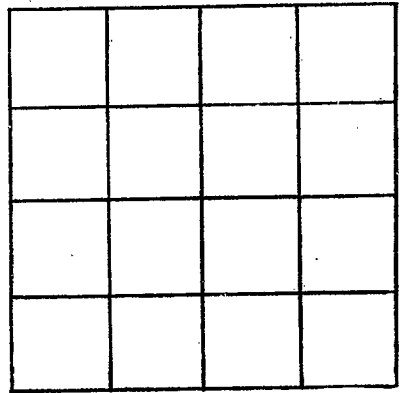

SECTION \_\_\_\_\_

Please indicate well location X.

ADDITIONAL INFORMATION

If more than one screen,  
show locations of each on sketch.