

OKTIBBEHA
C 25
7-6-72

MISSISSIPPI
 BOARD OF WATER COMMISSIONERS
 416 North State Street
 Jackson, Mississippi 39201

CODED

WATER WELL DRILLERS LOG

7-6 date well completed 32 Herman Echols firm name OKTibbeha county well located

LANDOWNER: <u>Charles Retherford</u>	description of formations encountered	from	to
<u>RFD</u>			
<u>Starkville, Miss -</u> (mailing address)	<u>Top Soil</u>	<u>0</u>	<u>6'</u>
	<u>Chalk</u>	<u>6'</u>	<u>680'</u>
	<u>Sand & Rock</u>	<u>680'</u>	

WELL LOCATION:
 sec. 27 T. 19 N. R. 14 E.
1 1/2 miles N of Starkville
 (distance) (direction) (nearest town)

WELL PURPOSE: Drury & Home
 (home, irrigation, municipal, industrial)

- WELL COMPLETION DATA:
- (1) diameter (inches) 5"
 - (2) total depth (feet) 820
 - (3) static water level (feet) 120' below top of ground.
 - (4) casing 21' 5" casing
 (material) (depth)
 (size) If telescope see back.
 - (5) screen _____
 (length) (depth to top)
 - (6) pump 3/4 sub (HP) 10 gal/min (yield gpm)
elec (type power)
 - (7) electric log No (yes or no)
 - (organization running log)
 - (8) how well bottom plugged _____

CODED

Handwritten scribbles and notes:
 5' casing
 400' 2"



NOV 20 1972

MISSISSIPPI STATE BOARD OF WATER COMMISSIONERS

DRILLERS REMARKS:

If well telescopes please
sketch and show depths.

GROUND LEVEL

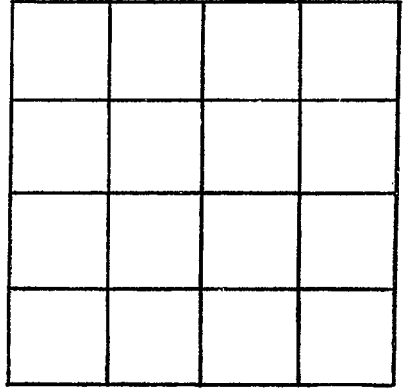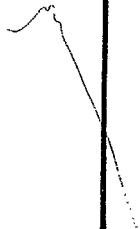

SECTION _____

Please indicate well location X.

ADDITIONAL INFORMATION

Lined area for entering additional information.

If more than one screen,
show locations of each on sketch.