

MISSISSIPPI DEPARTMENT OF NATURAL RESOURCES

Bureau of Land and Water Resources

Southport Mall

P.O. Box 10631

Jackson, Mississippi 39209

WATER WELL DRILLERS LOG

OKTBEHHA
C28
3-18-90

Coded

3/18 19 90
 date well completed

T. M. PARKS DRILLING COMPANY
 firm name

OKTBEHHA
 county well located

LANDOWNER: JIMMY ECKFORD/ECKFORD DAIRY FARM, POST OFFICE BOX 267 STARKVILLE, MS 39759 (mailing address)	description of formations encountered	from	to
WELL LOCATION: sec. 31 T. 20 (N) S. R. 14 (E) W	TOP SOIL	1	110
(distance) miles _____ of _____ (direction) (nearest town)	BLUE GUMBO W/CHALK	110	147
WELL PURPOSE: (home, irrigation, <u>municipal</u> , industrial)	CHALK W/LIMESTONE	147	447
WELL COMPLETION DATA: (1) diameter (inches) 8	SANDY WITH LIME	447	495
(2) total depth (feet) 861	CLAY WITH LIMESTONE	495	700
(3) static water level (feet) 168 below above top of ground.	FINE SANDY FORMATION W/CLAY	700	780
(4) casing <u>STAINLESS</u> 841 (material) (depth)	FINE SAND	780	800
5 x 4 (size) if telescope see back.	FAIR TO GOOD SAND	800	861
(5) screen 60 80 (length) (depth to top)			
4 STEEL (size) (material)			
(6) pump 5 50 (HP) (yield gpm)			
220 SINGLE PHASE (type power)			
(7) electric log NO (yes or no)			
(organization running log)			
(8) how well bottom plugged <u>BVP</u>			

RECEIVED


MAR 27 1990

Department of Natural Resources
 Bureau of Land & Water Resources

DRILLERS REMARKS:

If well telescopes please
sketch and show depths.

GROUND LEVEL

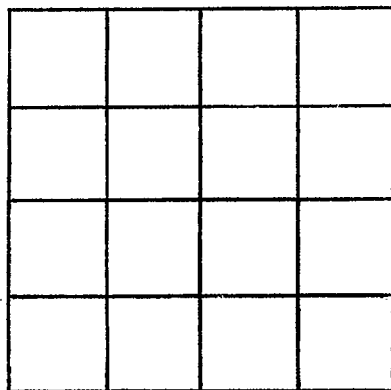

SECTION _____

Please indicate well location X.

ADDITIONAL INFORMATION

If more than one screen,
show locations of each on sketch.