

CODED

OKTIBBEHA

D 42

8-69

MISSISSIPPI BOARD OF WATER COMMISSIONERS

416 North State Street

Jackson, Mississippi 39201

ELOG #49

WATER WELL DRILLERS LOG

date well completed

1969 Hamden-Homan OkTibbeha

firm name

county well located

LANDOWNER

Clayton Ullage

description of formations encountered

from

to

Water Assoc.

Brown clay

0 10

Starbuck, Miss

Blue clay

10-480

(mailing address)

Shal-Rock

480-481

WELL LOCATION:

D 42

Sand

481-575

sec 32 T 19 N

R 15 E

Rock

575-576

NE 1/4

NE 1/4

NE 1/4

#

Sand

576-630

Blue clay

630-670

2 miles

(direction)

of Starbuck

Hard rock

670-672

(distance)

(direction)

(nearest town)

Sand

672-720

WELL PURPOSE:

COMMUNITY

(home, irrigation, municipal, industrial)

Blue clay

720-730

WELL COMPLETION DATA:

Sand

730-732

(1) diameter (inches)

8"

Blue clay

732-776

(2) total depth (feet)

1210'

Sand

776-820

(3) static water level (feet)

80 below top of ground.

Blue clay

820-845

(4) casing

Steel (material), 809 (depth)

Sand within gravel

845-853

8 (size) If telescope see back.

Blue clay

853-700

(5) screen

60' (length), 1026' (depth to top)

Sand

700-760

5" (size), 3045 (material) Stainless Steel

Blue clay

760-796

(6) pump

25 (HP), 250 (yield gpm)

Bank gully clay

796-1000

electric (type power)

Sand

1000-1115

(7) electric log

yes (yes or no)

Blue clay

1115-1125

USGS (organization running log)

Sand

1125-1205

(8) how well bottom plugged

B/W

Clayey clay

1205-1210

AUG 8 1969

DRILLERS REMARKS:

MISS. DE. OF WATER COMM

8

If well telescopes please sketch and show depths.

D

GROUND LEVEL


		X	

SECTION 32

Please indicate well location X.

ADDITIONAL INFORMATION

Lead
Sewer

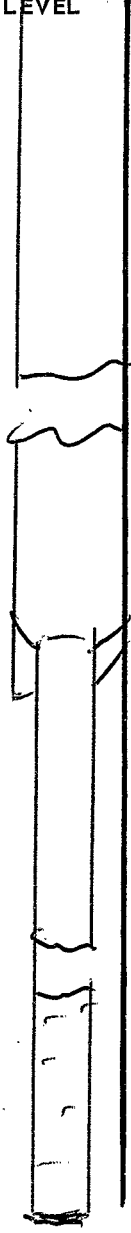

609' 8" CASING

5" Lead Pipe
Above Sewer
272'

depth to
1026

60' 95"
Sewer

8' W
Total: 1210' depth

top of Sewer

If more than one screen, show locations of each on sketch.