

CODED

MISSISSIPPI  
BOARD OF WATER COMMISSIONERS  
416 North State Street  
Jackson, Mississippi 39201

WATER WELL DRILLERS LOG

Ok Tibbeha  
D43  
5-23-68

May 23 1968 Echols Drilling Co OKTIBBEHA  
date well completed firm name county well located

LANDOWNER: HERMAN FOUNTAIN  
RT. 4 STARKVILLE  
(mailing address)

description of fomations encountered

from to  
2 10  
10 100  
190 300

Red Clay  
Hard Sand Rock  
Sand -

WELL LOCATION:  
sec. 2 T. 19 S. R. 15 E. W.  
10 miles NE of STARKVILLE  
(distance) (direction) (nearest town)

WELL PURPOSE: Home  
(home, irrigation, municipal, industrial)

WELL COMPLETION DATA:

- (1) diameter (inches) 3 3/4
- (2) total depth (feet) 300
- (3) static water level (feet) 63 below above top of ground.
- (4) casing PIPE 21  
(material) (depth)  
4  
(size) if telescope see back.
- (5) screen \_\_\_\_\_  
(length) (depth to top)  
(size) (material)
- (6) pump 3/4 6  
(HP) (yield gpm)  
Elec.  
(type power)
- (7) electric log NO  
(yes or no)  
(organization running log)
- (8) how well bottom plugged \_\_\_\_\_

Flow 220  
W.L. 63  
+ 157


JAN 21 1969

DRILLERS REMARKS: \_\_\_\_\_

MISS. BD. OF  
WATER COMM.

If well telescopes please sketch and show depths.

GROUND LEVEL

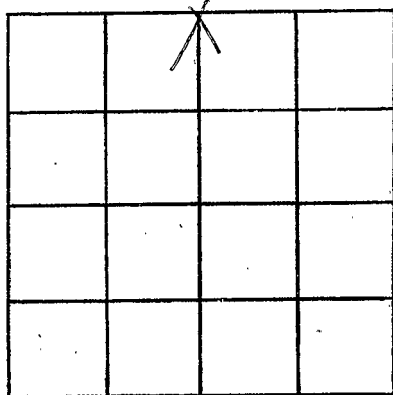

SECTION 2

Please indicate well location X.

ADDITIONAL INFORMATION

If more than one screen, show locations of each on sketch.