

Well No I
Camp House

OKTIBBEHA
D 44
7-25-69

MISSISSIPPI
BOARD OF WATER COMMISSIONERS
13E 416 North State Street
Jackson, Mississippi 39201

CODED

WATER WELL DRILLERS LOG

July 25 1969 date well completed
HERMAN ECHOLS firm name
OkTibbeha county well located

LANDOWNER: Ed Fore
Tuscaloosa Ala.
(mailing address)

description of formations encountered	from	to
	Top Soil	0
White Limestone Rock	4	336
Water Bearing Sand	336	440

WELL LOCATION:
sec 11 T 19 N R 15 E
S W
7 miles N. East of Studville
(distance) (direction) (nearest town)

WELL PURPOSE:
(home, irrigation, municipal, industrial)

WELL COMPLETION DATA:

- (1) diameter (inches) 4"
- (2) total depth (feet) 440
- (3) static water level (feet) 90 below top of ground.
- (4) casing 4 (material), 21 (depth),
(size) if telescope see back.
- (5) screen (length) (depth to top)
(size) (material)
- (6) pump 1 (HP), 5 (yield gpm)
(type power)
- (7) electric log none (yes or no)
(organization running log)
- (8) how well bottom plugged


NOV 10 1969

DRILLERS REMARKS:

Small illegible text at bottom right, possibly a stamp or reference code.

If well telescopes please
sketch and show depths.

GROUND LEVEL

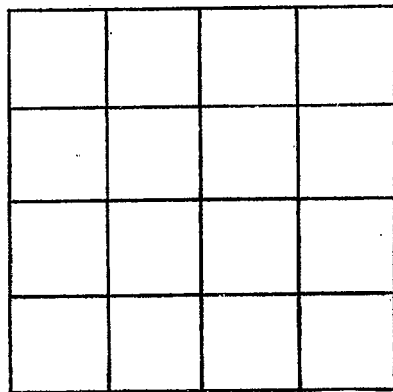

SECTION _____

Please indicate well location X.

ADDITIONAL INFORMATION

If more than one screen,
show locations of each on sketch.