

OKTIBBEHA
D-47
4-2-71

MISSISSIPPI
BOARD OF WATER COMMISSIONERS
416 North State Street
Jackson, Mississippi 39201

CODED

WATER WELL DRILLERS LOG

4/2 1971 Norman P. Cobb Oktibbeha
date well completed firm name county well located

LANDOWNER: Mike Jimm Thomas
RFD # 4
Starbuck, Miss.
(mailing address)

description of formations encountered	from	to
Silk dirt	0	9
Chalk	9	280
Sand & Rock	280	420

WELL LOCATION:
sec. 12 T20(N) R15(E)
S W
6 miles South of Westport
(distance) (direction) (nearest town)

WELL PURPOSE: Home
(home, irrigation, municipal, industrial)

- WELL COMPLETION DATA:
- (1) diameter (inches) 5"
 - (2) total depth (feet) 120
 - (3) static water level (feet) 120 below above top of ground.
 - (4) casing 21' 5" (material) (depth)
(size) if telescope see back.
 - (5) screen 0 (length) (depth to top)
(size) (material)
 - (6) pump 3/4 (HP) 10 (yield gpm)
Elev. (type power)
 - (7) electric log (yes or no)
(organization running log)
 - (8) how well bottom plugged Open

CODED


JUN 9 1971

MISS. BD. OF
WATER COMM.

DRILLERS REMARKS:

If well telescopes please sketch and show depths.

GROUND LEVEL

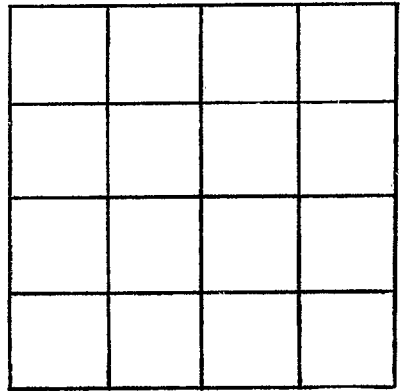

SECTION _____

Please indicate well location X.

ADDITIONAL INFORMATION

If more than one screen,
show locations of each on sketch.