

OK Tibbeha
D48
9-5-71

MISSISSIPPI
 BOARD OF WATER COMMISSIONERS
 416 North State Street
 Jackson, Mississippi 39201

CODED

WATER WELL DRILLERS LOG

HERMAN ECHOLS
 ROUTE 4
 STARKVILLE, MISS.

O. Tibbeha


Sept 15 19*71*
 day well completed

county well located

LANDOWNER: *Joe Mann*
R7D #4
Starkville, Miss
 (mailing address)

description of formations encountered	from	to
<i>Sand & Clay</i>	<i>0</i>	<i>15</i>
<i>Chalk</i>	<i>15</i>	<i>500</i>
<i>Sand & Rock</i>	<i>500</i>	<i>650</i>


WELL LOCATION:
 sec *31* T. *19* (N) R. *15* (E)
4 miles *East* of *Starkville*
 (distance) (direction) (nearest town)

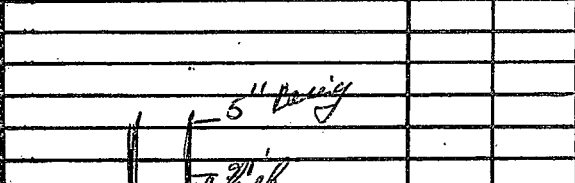

WELL PURPOSE: *Water Court*
 (home, irrigation, municipal, industrial)

- WELL COMPLETION DATA:
- (1) diameter (inches) *5"*
 - (2) total depth (feet) *650*
 - (3) static water level (feet) *98* below above top of ground.
 - (4) casing *5"* *21'*
 (material) (depth)
 (size) if telescope see back.
 - (5) screen (length) (depth to top)
 (size) (material)
 - (6) pump *1"* *10*
 (HP) (yield gpm)
Ch.
 (type power)
 - (7) electric log (yes or no) *OCT 14 1971*
 (organization running log) MISS. BD. OF WATER COM.
 - (8) how well bottom plugged

CODED

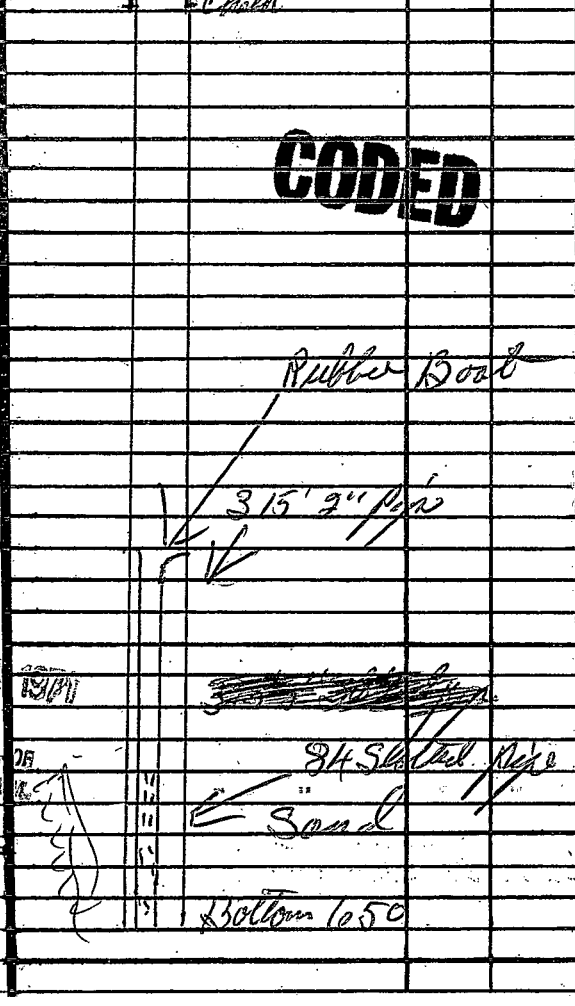

DRILLERS REMARKS:
Well was pump with air
water was clear
approx 50 G.P.M.

If well telescopes please sketch and show depths.

GROUND LEVEL

[Handwritten signature]

*1580
1585
1590*

*20 feet
20 feet
20 feet*

10" dia

18" dia

12' 9" dia

20' dia

20'

If more than one screen, show locations of each on sketch.

Bottom 120

	17	21	22
<i>Location</i>			
		18	19
20	21	22	23

[Handwritten signature] SECTION _____

Please indicate well location X.

ADDITIONAL INFORMATION

10"

120'

18'

18"

10'

17"

17'