

OKTIBBEHA
D50
11-10-72

MISSISSIPPI
 BOARD OF WATER COMMISSIONERS
 416 North State Street
 Jackson, Mississippi 39201

CODED

WATER WELL DRILLERS LOG

Nov 10 1972 J.W. Webb & Sons Okibbeha
 date well completed firm name county well located

LANDOWNER: Donald Winters
P.O. Box 3609
Mississippi State College
 (mailing address)

description of formations encountered	from	to
<u>topsoil dred clay</u>	<u>0</u>	<u>7</u>
<u>limestone</u>	<u>4</u>	<u>10</u>
<u>blue marl</u>	<u>10</u>	<u>220</u>
<u>dark blue sand & shale</u>	<u>220</u>	<u>460</u>

WELL LOCATION:
 sec. 35 T. 19 (N) R. 15 (E)
 S W
6 miles East of Starkville
 (distance) (direction) (nearest town)

WELL PURPOSE: home
 (home, irrigation, municipal, industrial)

- WELL COMPLETION DATA:
- (1) diameter (inches) 4"
 - (2) total depth (feet) 460 ft
 - (3) static water level (feet) 80 below above top of ground.
 - (4) casing steel 21 ft
 (material) (depth)
4"
 (size) if telescope see back.
 - (5) screen _____
 (length) (depth to top)
 (size) (material)
 - (6) pump 1/2 sub 8
 (HP) (yield gpm)
elect
 (type power)
 - (7) electric log NO
 (yes or no)
 (organization running log)
 - (8) how well bottom plugged open
hole


CODED

DRILLERS REMARKS: _____

JUN 18 1974

If well telescopes please sketch and show depths.

GROUND LEVEL

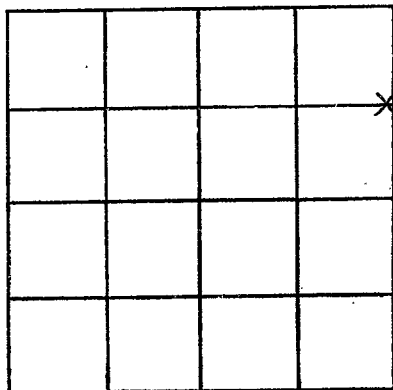

SECTION 35

Please indicate well location X.

ADDITIONAL INFORMATION

If more than one screen, show locations of each on sketch.