

Oktibbeha  
 D 51  
 5-21-73

MISSISSIPPI  
 BOARD OF WATER COMMISSIONERS  
 416 North State Street  
 Jackson, Mississippi 39201

**CODED**

WATER WELL DRILLERS LOG

5/21 1973 Norman Phelps Oktibbeha  
 date well completed firm name county well located

LANDOWNER: Mary Johnson  
RFD. no 4  
Starbelle, miss  
 (mailing address)

description of formations encountered	from	to
<u>Clay</u>	<u>0</u>	<u>7</u>
<u>Shale</u>	<u>7</u>	<u>150</u>
<u>Sand</u>	<u>150</u>	<u>570</u>

WELL LOCATION:  
 sec. 15 T. 19 (N) R. 15 (E)  
 S W  
7 miles W of Starbelle  
 (distance) (direction) (nearest town)

WELL PURPOSE: Home  
 (home, irrigation, municipal, industrial)

- WELL COMPLETION DATA:
- (1) diameter (inches) 5
  - (2) total depth (feet) 570
  - (3) static water level (feet) ✓ below above top of ground.
  - (4) casing 5" 21'  
 (material) (depth)  
 (size) if telescope see back.
  - (5) screen 0   
 (length) (depth to top)  
 (size) (material)
  - (6) pump 1/2 7  
 (HP) (yield gpm)  
E. Cab.  
 (type power)
  - (7) electric log   
 (yes or no)  
 (organization running log)
  - (8) how well bottom plugged


**CODED**

DRILLERS REMARKS:  
Repaired red well

JUL 30 1973

If well telescopes please sketch and show depths.

GROUND LEVEL

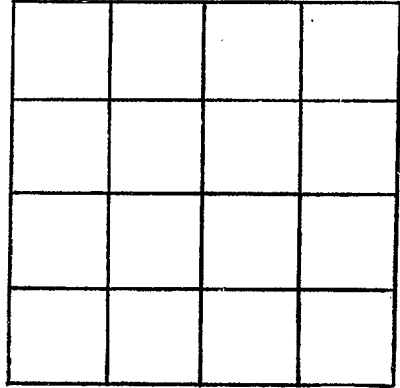

SECTION \_\_\_\_\_

Please indicate well location X.

ADDITIONAL INFORMATION

A series of horizontal lines for recording additional information.

If more than one screen, show locations of each on sketch.