

OKTIBBEHA

D 56

1/4/78

1/4/78

date well completed

BOARD OF WATER COMMISSIONERS
416 North State Street
Jackson, Mississippi 39201

CODED

WATER WELL DRILLERS LOG

G-tiver Drilling Service
firm name

Oktibbeha
county well located

LANDOWNER: Amoco Production Co
Amoco-Burgin Brothers # 1

(mailing address)

WELL LOCATION:

sec. 22 T. 19 N. R. 15 E
1796 W. 1971 W of SE Cor Starkville
miles (distance) of (direction) (nearest town)

WELL PURPOSE:

(home, irrigation, municipal, industrial)

WELL COMPLETION DATA:

- (1) diameter (inches) 3"
 - (2) total depth (feet) 535'
 - (3) static water level (feet) 140' ^{below} top of ground.
 - (4) casing Steel 357' (material) (depth)
3" (size) If telescope see back.
 - (5) screen 42' 315' (length) (depth to top)
3" Perforated Pipe (size) (material)
 - (6) pump 55 (HP) (yield gpm)
AC (type power)
 - (7) electric log 110 (yes or no)
- (organization running log)

(8) how well bottom plugged orange
Peel

DRILLERS REMARKS:

Sand

description of formations encountered

from

to

Top Soil

0

21

Chalk

21

105

Chalk + Sand

106

126

Stratified

137

231

Chalk + Rock

232

273

Stratified + Chalk

274

378

Rock + Chalk

379

399

Chalk

400

411

Stratified

412

504

Chalk

505


525

RECEIVED
FEB 10 1978

MISS. BD. OF WATER COMMISSIONERS

If well telescopes please sketch and show depths.

GROUND LEVEL

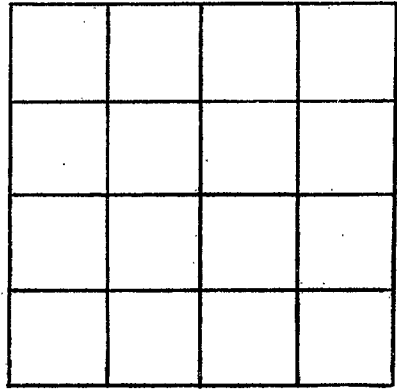

SECTION _____

Please indicate well location X.

ADDITIONAL INFORMATION

If more than one screen,
show locations of each on sketch.