

Obtiskha  
D 2000  
8-5-75

MISSISSIPPI  
 BOARD OF WATER COMMISSIONERS  
 416 North State Street  
 Jackson, Mississippi 39201

WATER WELL DRILLERS LOG

8/5 1975 Norman Ebers Obtiskha  
 date well completed firm name county well located

LANDOWNER: Cleveland Brown  
R 7 D # 4  
Starbelle, Miss  
 (mailing address)

description of formations encountered	from	to
<u>Red clay</u>	<u>0</u>	<u>8</u>
<u>Black sand</u>	<u>8</u>	<u>330</u>
	<u>330</u>	<u>450</u>

WELL LOCATION:  
 sec. 3 T 19 N R 15 E 13E  
S W  
10 miles W E of Starbelle  
 (distance) (direction) (nearest town)

WELL PURPOSE:  
 (home, irrigation, municipal, industrial)


- WELL COMPLETION DATA:
- (1) diameter (inches) 5 Plastic
  - (2) total depth (feet) 450
  - (3) static water level (feet) 85 below above top of ground.
  - (4) casing 20" Plastic 5"  
 (material) (depth)  
 (size) if telescope see back.
  - (5) screen \_\_\_\_\_  
 (length) (depth to top)  
 (size) (material)
  - (6) pump 1 5  
 (HP) (yield gpm)  
E bit  
 (type power)
  - (7) electric log \_\_\_\_\_  
 (yes or no)  
 (organization running log)
  - (8) how well bottom plugged ⊙

DRILLERS REMARKS:

RECEIVED  
 NOV 12 1975

If well telescopes please sketch and show depths.

GROUND LEVEL

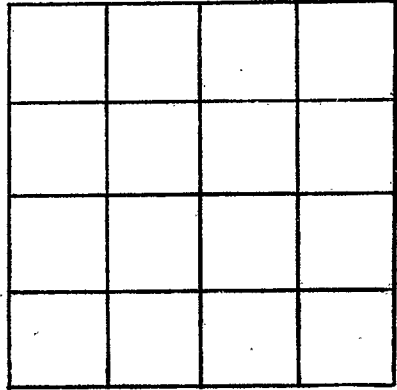

SECTION \_\_\_\_\_

Please indicate well location X.

ADDITIONAL INFORMATION

If more than one screen, show locations of each on sketch.