

OKTIBBEHA

D 2001

7/18/76

MISSISSIPPI
 BOARD OF WATER COMMISSIONERS
 416 North State Street
 Jackson, Mississippi 39201

13E

WATER WELL DRILLERS LOG

7/19

date well completed

1976

Norman Cabell

firm name

OKTibbeha

county well located

LANDOWNER:

Jack Bryant

description of formations encountered

from

to

Starbelle, Miss
(mailing address)

Top Soil & Sand

0

20

Thin Rock

20

280

Sand

280

420

WELL LOCATION:

sec. 35 T. 20 N. R. 15 E.
S W

8 miles North East of Starbelle
(distance) (direction) (nearest town)

WELL PURPOSE: Camp Ground
(home, irrigation, municipal, industrial)

WELL COMPLETION DATA:

- (1) diameter (inches) 4 1/2
- (2) total depth (feet) 420
- (3) static water level (feet) 11 below above top of ground.

- (4) casing 26' 6" Plastic; (material) (depth)

(size) if telescope see back.

- (5) screen (length) (depth to top)

(size) (material)

- (6) pump 1/2 (HP) 10 (yield gpm)

Elct
(type power)

- (7) electric log no (yes or no)

(organization running log)

- (8) how well bottom plugged


DRILLERS REMARKS:

RECEIVED
SEP - 7 1976

MISS. BD. OF WATER COMMISSIONERS

If well telescopes please sketch and show depths.

GROUND LEVEL

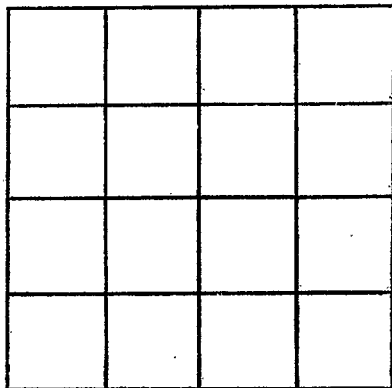

SECTION _____

Please indicate well location X.

ADDITIONAL INFORMATION

If more than one screen, show locations of each on sketch.