

OKTIBBEHA

D 2004

5-26-77

MISSISSIPPI
 BOARD OF WATER COMMISSIONERS
 416 North State Street
 Jackson, Mississippi 39201

WATER WELL DRILLERS LOG

May 26 1977

13E

J. W. Webb & Sons

OkTibbeth

date well completed

firm name

county well located

LANDOWNER: Dr. W. M. Boat

Dr. W. M. Boat

description of formations encountered

from

to

Starkville Miss.
(mailing address)

Soil
Sand & Clay
Blue Rock
Water Sand
Ataw Sand

0 1
1 17
17 487
487 700

WELL LOCATION:

sec 30 T19N R15E S

1.34 miles N-East of Starkville
(distance) (direction) (nearest town)

WELL PURPOSE:

(home, irrigation, municipal, industrial)

WELL COMPLETION DATA:

- (1) diameter (inches) 5"
- (2) total depth (feet) 700'
- (3) static water level (feet) 178 below above top of ground.
- (4) casing Steel 21' (material) (depth)

(size) If telescope see back.

- (5) screen (length) (depth to top)

(size) (material)

- (6) pump 1-1/2 HP 16 (HP) (yield gpm)
Elec (type power)

- (7) electric log (yes or no)

(organization running log)

- (8) how well bottom plugged


DRILLERS REMARKS:

RECEIVED
JUN 9 1977

MISS. Bd. OF WATER COMMISSIONERS

If well telescopes please sketch and show depths.

GROUND LEVEL

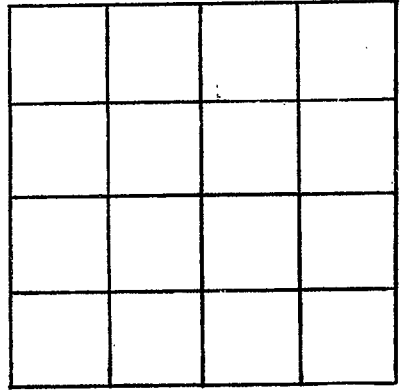

SECTION _____

Please indicate well location X.

ADDITIONAL INFORMATION

If more than one screen,
show locations of each on sketch.