

OK Tibbeha
D 205
11/18/77

MISSISSIPPI
 BOARD OF WATER COMMISSIONERS
 416 North State Street
 Jackson, Mississippi 39201

WATER WELL DRILLERS LOG

Herman Homan Well & Supply, Inc.
 P. O. Box 42

11-18 1977
 date well completed

SHANNON, MISSISSIPPI 38600

OK Tibbeha
 county well located

LANDOWNER:

Betta House
West Point MS
 (mailing address)

description of formations
 encountered

from to

Surface clay 0 16
Blue clay 16 260
Sand 260 400
Gravel 400

WELL LOCATION:

sec. 12 T. 19 N. R. 15 E.
5 miles W of Tibbeha
 (distance) (direction) (nearest town)

WELL PURPOSE: Home
 (home, irrigation, municipal, industrial)

WELL COMPLETION DATA:

- (1) diameter (inches) 4"
- (2) total depth (feet) 420'
- (3) static water level (feet) 14' below top of ground.
- (4) casing Steel, 21'
 (material) (depth)
4" If telescope see back.
 (size)
- (5) screen no,
 (length) (depth to top)
 (size) (material)
- (6) pump 1/2 5
 (HP) (yield gpm)
electric
 (type power)
- (7) electric log no
 (yes or no)

(organization running log)

(8) how well bottom plugged open

RECEIVED


DEC 22 1977

DRILLERS REMARKS:

MISS. BD. OF WATER COMM

relescopes please
sketch and show depths.

GROUND LEVEL

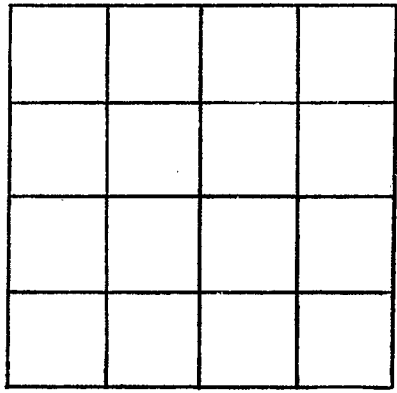

SECTION _____

Please indicate well location X.

ADDITIONAL INFORMATION

A series of horizontal lines for writing additional information, starting below the 'ADDITIONAL INFORMATION' header and extending to the bottom of the page.

If more than one screen,
show locations of each on sketch.