

MISSISSIPPI DEPARTMENT OF ENVIRONMENTAL QUALITY
Bureau of Land and Water Resources

P. O. Box 10631
Jackson, MS 39289-0631
WATER WELL DRILLERS LOG

COUNTY WELL LOCATED Oktibbeha	
WELL NUMBER 1277	CODED D 2006
Rose Williams	
DATE WELL COMPLETED 03-20-92	

PERMIT NUMBER 0-379
NAME OF DRILLING FIRM Mid South Drilling Co.
Carrollton, AL 35447

NAME & MAILING ADDRESS OF LANDOWNER		
O. C. Electric (contractor)		
P. O. Box 581		
Columbus, MS 39703		
WELL LOCATION: SEC	TOWNSHIP	RANGE
12	19	N 15 W
DISTANCE	DIRECTION	NEAREST TOWN
5.5 Miles	S	West Point
OTHER LANDMARK		
WELL PURPOSE: Home, Irrigation, Municipal, Industrial, Fish Pond, etc. home		

PUMP DATA		
PUMP TYPE (Circle One): Submersible, Turbine, Jet, Flowing Well, Other (Describe) _____		
POWER TYPE (Circle One): Electric, Tractor, Diesel, Gasoline, Butane, Other (Describe) _____ H/P _____		
Pump Capacity (GPM)	No. of Stages	Setting Depth
		FT.
PUMP TEST		
Well yielded _____ GPM with a drawdown of _____ ft. after _____ hours of pumping		

WELL DATA		
Well Depth 450	Casing Diameter (In.) 4x2	Casing Length (Ft.) 350
Type of Casing PVC	Hole Depth 450	Depth to Static Water Level 150
TYPE OF COMPLETION: (Circle One or More): Gravel Packed, Underreamed, Telescoped , Natural Development, Open Hole, Other _____ (Describe) _____		
Top of Lap Pipe or Reduction in Casing 254 FEET		
IF TELESCOPED OR MORE THAN ONE SCREEN: USE BACK PAGE		

LOG DATA	
TYPE OF LOG RUN (Circle One): Electric, Gamma Ray, Density, Sonic, Neutron, Other (Describe) _____	
No Log Run	
Name of Organization Running Log _____	


SCREEN DATA		
Diameter - Inches 2	Length - Feet 100	Slot Size - Inches .014
Screen Type PVC	Depth to Bottom - Feet 350	

GEOLOGIC DATA (Office Use Only)			
Surface Elev.	Geologic Unit	Unit Thickness	Depth to Top
Subs. SWL	Date	Analysis	Aquifer Test
Driller's Remarks			

DESCRIPTION OF FORMATIONS ENCOUNTERED	FROM	TO
clay	0	296
sand	296	312
rock	312	314
sand	314	317
rock	317	319
sand	319	335
rock	335	337
sand w/clay streaks	337	370
sand	370	444
clay w/sand streaks	444	450

FORMATIONS (Continued)	FROM	TO
RECEIVED		
APR 13 1992		
Dept. of Environmental Quality		
Bureau of Land & Water Resources		
IF MORE SPACE IS NEEDED, USE BACK		

If well telescopes please sketch and show depths.

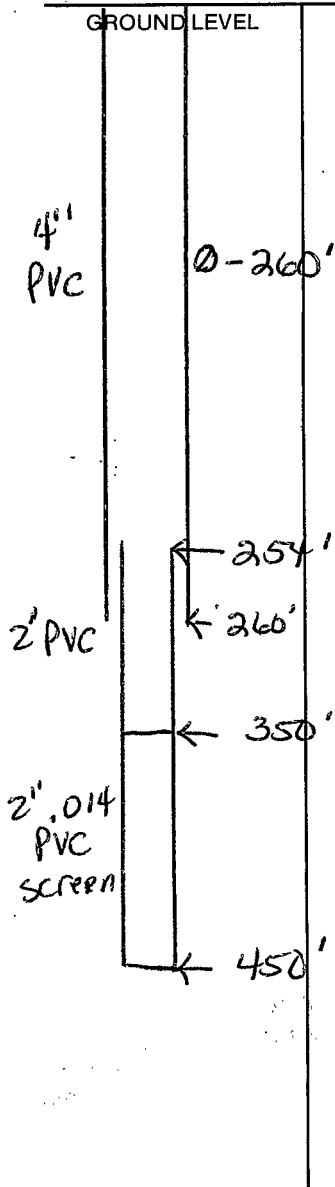

SECTION _____

Please indicate well location X.

ADDITIONAL INFORMATION

If more than one screen, show location of each on sketch.