

WATER WELL DRILLERS LOG

OKT. 2000
 E
 Date: 4/1, 1962, Driller: HERMAN ECHOLS County OKT. BEA
 4-62

(Name)

(1) Owner of Land: H. E. TAYLOR
 (Name)
STARGIS MISS
 (Address)

(2) Location: 1/4, 1/4, Sec 27 T18 R24E
5 miles NORTH EAST of STARGIS
 (distance) (direction) (Nearest Town)

(3) Topography: (Hilly) (Flat) (Level)

(4) Purpose of Well: (Domestic) Irrigation
 Municipal, Industrial, Other

Description & Color of Materials Sand, Clay, Red Clay, Shell, etc.	Thick- ness Feet	Depth Feet
<u>Clay & top Soil</u>	<u>15</u>	<u>15</u>
<u>PORTERS CREEK Clay</u>		
<u>DARK</u>	<u>485</u>	<u>500</u>
<u>SELMA CHALK</u>	<u>651</u>	<u>1151</u>
<u>LINE</u>		
<u>Muddy sand & gravel</u>	<u>126</u>	<u>1277</u>
<u>Rock & SAND</u>	<u>126</u>	<u>1403</u>

Information upon completion of well:

(1) Diameter 4 inches.

(2) Total Depth 1403 feet.

(3) Water Level feet below top of ground.


(4) Cased to 100' 4, Size 1303-2"

(5) Screen: Size PEREIRA length 80'
PIPE

(6) Were any formations sealed against pollution?
 yes, NO no.

If YES depth of formation
 Why

Drillers Remarks:
Water table was not known @ time well was completed

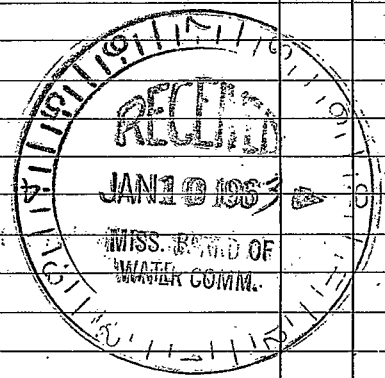

(Use Back Side)

Well No.

1. The first part of the document discusses the importance of maintaining accurate records of all transactions and activities. It emphasizes the need for transparency and accountability in financial reporting.

2. The second part of the document outlines the various methods and techniques used to collect and analyze data. It includes a detailed description of the experimental procedures and the tools used for data collection.

3. The third part of the document presents the results of the study, including a comparison of the different methods and techniques used. It discusses the strengths and weaknesses of each method and provides a summary of the findings.

4. The fourth part of the document discusses the implications of the study and provides recommendations for future research. It highlights the need for further investigation into the effectiveness of the different methods and techniques used.

5. The fifth part of the document provides a conclusion and a summary of the key findings. It reiterates the importance of maintaining accurate records and the need for transparency and accountability in financial reporting.