

OKTIBBEHA

~~OKTIBBEHA~~ F27

12-29-74

MISSISSIPPI
BOARD OF WATER COMMISSIONERS
416 North State Street
Jackson, Mississippi 39201

CODED

106

WATER WELL DRILLERS LOG

12/29
date well completed

1974

Hermon E. Cole
firm name

OkTibbeha
county well located

LANDOWNER:

Charles Thomas

Starbelle, Miss

(mailing address)

description of formations encountered

*Black clay
Chalk
Sand*

from

to

*0 100
105 185
785 950*

WELL LOCATION:

sec. 2 T. 18 (N) R. 13 (E) ^{13E}

4 miles West of STARKVILLE
(distance) (direction) (nearest town)

WELL PURPOSE: Home
(home, irrigation, municipal, industrial)

WELL COMPLETION DATA:

- (1) diameter (inches) 4"
- (2) total depth (feet) 950
- (3) static water level (feet) 130 below above top of ground.
- (4) casing _____ (material) _____ (depth) _____ (size) if telescope see back.
- (5) screen _____ (length) _____ (depth to top) _____ (size) _____ (material)
- (6) pump 1/2 _____ (HP) 9 _____ (yield gpm)
Chart (type power)
- (7) electric log no _____ (yes or no)
_____ (organization running log)
- (8) how well bottom plugged _____

CODED

*120
Bell L.P.V.D.
2 1/2" HOLE casing
Casing*

*4 1/2"
Benton
500' 2" casing
100' S. L.P.V.D.*


500'

DECEMBER 16 1974

DRILLERS REMARKS:

If well telescopes please sketch and show depths.

GROUND LEVEL

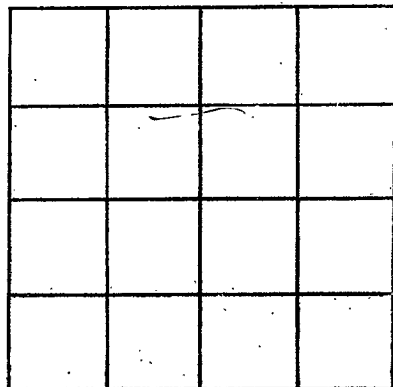

SECTION _____

Please indicate well location X.

ADDITIONAL INFORMATION

If more than one screen,
show locations of each on sketch.