

~~OKATIBBE~~  
~~OKATIBBE~~  
 OKTIBBE  
 F28  
 3-75

MISSISSIPPI  
 BOARD OF WATER COMMISSIONERS  
 416 North State Street  
 Jackson, Mississippi 39201

WATER WELL DRILLERS LOG CODED

Jan Feb + March 1975 *Norman E. Eber* <sup>106</sup> *A. T. Tillis*  
 date well completed firm name county well located


LANDOWNER: *Eliza Williams*  
*R7D #3*  
*Starbelle Missi 39759*  
 (mailing address)

description of formations encountered	from	to
<i>Black clay</i>	<i>0</i>	<i>105</i>
<i>Clay</i>	<i>105</i>	<i>785</i>
<i>S on 1st Rock</i>	<i>785</i>	<i>950</i>

WELL LOCATION:  
 sec. 2 T. 18 N. R. 13 E.  
4 miles West of Starbelle  
 (distance) (direction) (nearest town)

WELL PURPOSE: Home  
 (home, irrigation, municipal, industrial)

- WELL COMPLETION DATA:
- (1) diameter (inches) 4"
  - (2) total depth (feet) 950
  - (3) static water level (feet) 140 below above top of ground.
  - (4) casing 126' 4" Steel  
 (material) (depth)  
 (size) if telescope see back.
  - (5) screen \_\_\_\_\_  
 (length) (depth to top).  
 (size) (material)
  - (6) pump 3/4 10  
 (HP) (yield gpm)  
E. Eber  
 (type power)
  - (7) electric log no  
 (yes or no)  
 (organization running log)
  - (8) how well bottom plugged 0

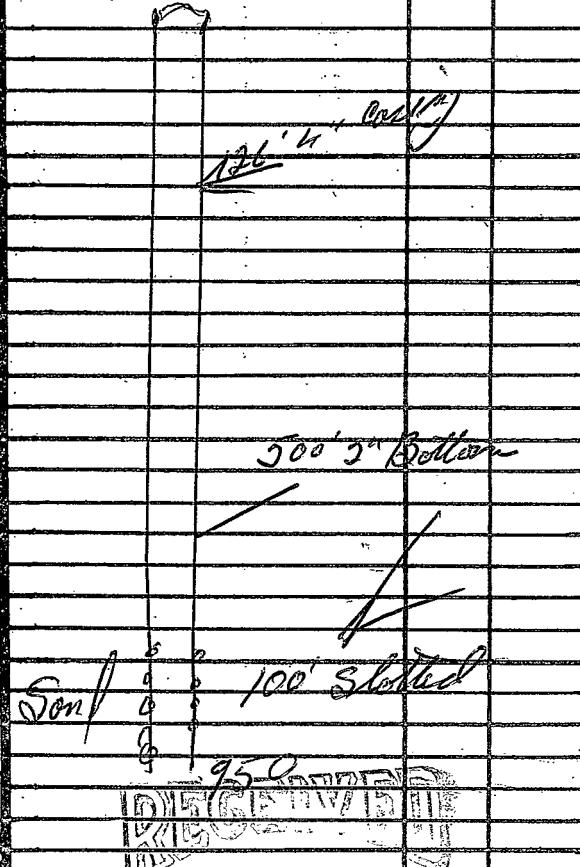


DRILLERS REMARKS: \_\_\_\_\_

MAY 19 1975  
 MISS. BU. OF WATER COMMISSIONERS

If well telescopes please sketch and show depths.

GROUND LEVEL

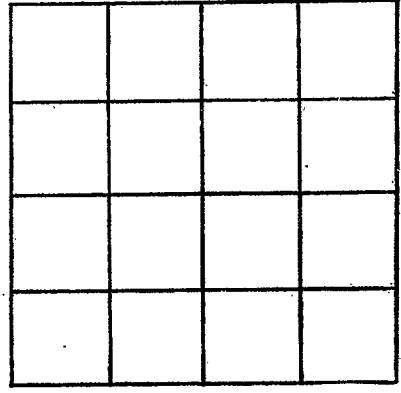

SECTION \_\_\_\_\_

Please indicate well location X.

ADDITIONAL INFORMATION

Lined area for additional information, consisting of approximately 20 horizontal lines.

If more than one screen, show locations of each on sketch.