


OKTIBBEHA
F30
4-30-81

MISSISSIPPI
 BOARD OF WATER COMMISSIONERS
 416 North State Street
 Jackson, Mississippi 39201

WATER WELL DRILLERS LOG

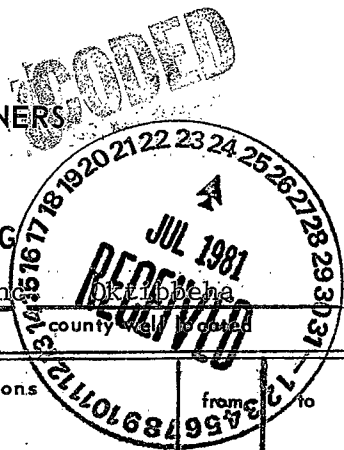

30 April 1981 Herndon Well & Supply, Inc. firm name
 date well completed

| LANDOWNER: <u>Bradley Water Ass'n., Inc., Rt. 2, Box 154- Starkville, MS 39759 (mailing address)</u> | description of formations encountered | from | to | |
|---|---------------------------------------|------|------|--|
| WELL LOCATION: sec. <u>32</u> T <u>18</u> N R. <u>13</u> E <u>6</u> miles West of <u>Starkville</u> (distance) (direction) of (nearest town) | Brown Sand & Clay | 0 | 15 | |
| | Blue Clay | 15 | 287 | |
| | Lime Rock | 287 | 840 | |
| | Sand & Blue Clay | 840 | 1160 | |
| | Rock | 1160 | 1300 | |
| | Sand & Blue Clay | 1300 | 1335 | |
| | Rock | 1335 | 1336 | |
| | Sand & Blue Clay | 1336 | 1430 | |
| | Rock | 1430 | 1431 | |
| | Blue Clay | 1431 | 1510 | |
| WELL PURPOSE: <u>Municipal</u> (home, irrigation, municipal, industrial) | Pink Clay | 1510 | 1638 | |
| | Coarse Sand | 1638 | 1650 | |
| | Pink Clay | 1650 | 1714 | |
| | Sand | 1714 | 1725 | |
| | Pink Clay | 1725 | 1750 | |
| | Sand | 1750 | 1794 | |
| | Pink Clay | 1794 | 1796 | |
| | | | | |
| | | | | |
| | | | | |
| WELL COMPLETION DATA: (1) diameter (inches) <u>8"</u> (2) total depth (feet) <u>1798'</u> (3) static water level (feet) <u>155'</u> below top of ground. (4) casing <u>Steel</u> <u>1304'</u> (material) (depth) <u>8"</u> if telescope see back. (size) (5) screen <u>41'</u> (length) (depth to top) <u>4"</u> <u>Stainless</u> (size) (material) (6) pump <u>20</u> <u>172</u> (HP) (yield gpm) <u>Electric</u> (type power) (7) electric log <u>yes</u> (yes or no) <u>M. G. S.</u> (organization running log) (8) how well bottom plugged | | | | |
| | | | | |
| | | | | |
| DRILLERS REMARKS: | | | | |
| | | | | |
| | | | | |
| | | | | |

2

If well telescopes please sketch and show depths.

GROUND LEVEL

| | | | |
|--|--|--|--|
| | | | |
| | | | |
| | | | |
| | | | |

SECTION 32

Please indicate well location X.

ADDITIONAL INFORMATION

Top of Lap 1249

Bottom casing 1304

41' Screen .015

Bottom 1798

11' of 4" diam

1798
 11
 1787
 4
 1783

If more than one screen, show locations of each on sketch.