

MISSISSIPPI DEPARTMENT OF NATURAL RESOURCES

Bureau of Land and Water Resources

Southport Mall

P.O. Box 10631

Jackson, Mississippi 39209

CODED

WATER WELL DRILLERS LOG

Griner Drilling Service, Inc.

OKtibbeha

F32
OKtibbeha Co.
1-10-84

1-10-84
date well completed

firm name

county well located

LANDOWNER:	description of formations encountered	from	to
(mailing address)			
Amoco Production P.O. Box 51921 Lafayette, La 70505	clay, rock	0	300
WELL LOCATION: 1000'N + 1500'E sec. 7 T-18N R-13E SW/4	clay, hard gumbo	300	1050
No. 1 Longview Ret. Timber (distance) miles (direction) of (nearest town)	streaked sand	1050	1210
WELL PURPOSE: oil field supply (home, irrigation, municipal, industrial)	rock, clay	1210	1218
WELL COMPLETION DATA:	SE, SW		
(1) diameter (inches) 3"			
(2) total depth (feet) 1218'			
(3) static water level (feet) 130' (below) above top of ground.			
(4) casing steel, 1218' (material) (depth) 3" (size) if telescope see back.			
(5) screen 126' (length), 1092' (depth to top) 3" perforated (size) (material)			
(6) pump AC (HP) 60-70 (yield gpm) (type power)			
(7) electric log (yes or no) (organization running log)			
(8) how well bottom plugged orange peel			

CODED

DEPT. OF NATURAL RESOURCES
BUREAU OF LAND & WATER RESOURCES


JAN 23 1984

RECEIVED

DRILLERS REMARKS:

If well telescopes please sketch and show depths.

GROUND LEVEL

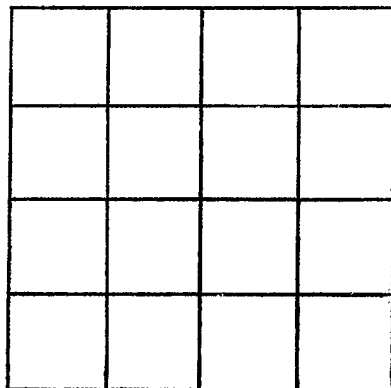

SECTION _____

Please indicate well location X.

ADDITIONAL INFORMATION

If more than one screen, show locations of each on sketch.