

Oltibheha
F 2000
7-30-75

MISSISSIPPI
 BOARD OF WATER COMMISSIONERS
 416 North State Street
 Jackson, Mississippi 39201

WATER WELL DRILLERS LOG

7/30 1975 Norman Elder W. J. Tuttle
 date well completed firm name county well located

LANDOWNER: Wayne Parker
RD # 3
Stadhall, Miss
 (mailing address)

description of formations encountered	from	to
<u>top Soil</u>	<u>0</u>	<u>110</u>
<u>Chalky</u>	<u>110</u>	<u>220</u>
<u>Sand</u>	<u>220</u>	<u>250</u>

WELL LOCATION:
 sec. 2 T. 18N R. 13E
S W 13E
5 miles West of Stadhall
 (distance) (direction) (nearest town)

WELL PURPOSE: Home
 (home, irrigation, municipal, industrial)

- WELL COMPLETION DATA:
- (1) diameter (inches) 4"
 - (2) total depth (feet) 250
 - (3) static water level (feet) 120 below top of ground.
 - (4) casing 126' 4" top, 300' 2" Bottom
 (material) (depth)
 (size) If telescope see back.
 - (5) screen _____ (length) _____ (depth to top)
 (size) (material)
 - (6) pump 1/2 10
 (HP) (yield gpm)
Electric
 (type power)
 - (7) electric log _____ (yes or no)
 (organization running log)
 - (8) how well bottom plugged _____

None

the well has 200'

2" pipe in bottom

100' S. level in sand


RECEIVED
 NOV 12 1975

DRILLERS REMARKS:

MISS. BD. OF WATER COMMISSIONERS

If well telescopes please sketch and show depths.

GROUND LEVEL

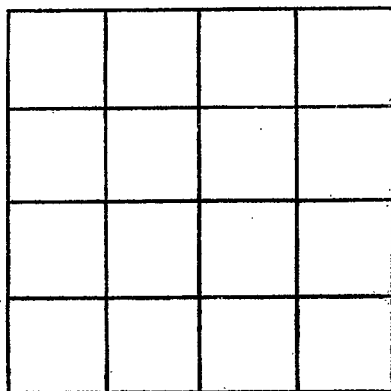

SECTION _____

Please indicate well location X.

ADDITIONAL INFORMATION

If more than one screen,
show locations of each on sketch.