

**OKTIBBEHA**  
**G11**  
**S175**  
**E Log # 63**

**MISSISSIPPI**  
**BOARD OF WATER COMMISSIONERS**  
 416 North State Street  
 Jackson, Mississippi 39201 **CODED**

**WATER WELL DRILLERS LOG**

May 1975 Herndon Well & Supply, Inc. Oktibbeha  
 date well completed firm name county well located

LANDOWNER:	description of formations encountered	from	to
Oktoc Water Association, Inc.	Red Clay & Gumbo	0	30
Starkville, Ms 39759	Gray Gumbo	30	720
(mailing address)	Gray Sand & Gumbo	720	780
<b>WELL LOCATION:</b>	Sandy Gumbo, 6" rock 795	780	810
sec. 35 T 18 N R 14 E	Gumbo to 6" rock @ 820	810	840
8 miles SW of Starkville	Gumbo	840	870
(distance) (direction) (nearest town)	Sandy Gumbo	870	960
<b>WELL PURPOSE: Community</b>	Gumbo	960	990
(home, irrigation, municipal, industrial)	Gumbo & Sand-Stk. Rock	990	1020
<b>WELL COMPLETION DATA:</b>	Gumbo, 1" Rock @1049	1020	1050
(1) diameter (inches) 8 x 4 inch	Gumbo	1050	1170
(2) total depth (feet) 1457	10' Gumbo, 20' Sand	1170	1200
(3) static water level (feet) 132 below top of ground.	Sandy Gumbo, 1' rock @1215	1200	1230
(4) casing Steel 1320 (material), (depth)	Gumbo: Pink Gumbo: 1310	1230	1320
8 (size) If telescope see back.	Gumbo Sand 8' Sand: 1342	1320	1350
(5) screen 50 (length), (depth to top)	Sand	1350	1410
4 Stainless (size), (material)	Sand and Gravel	1410	1440
(6) pump 20 (HP) 197 (yield gpm)	Gravel & 5' Gumbo	1440	1457
Elec (type power)			
(7) electric log Yes (yes or no)			
USGS (organization running log)			
(8) how well bottom plugged			
4" BWV			


**DRILLERS REMARKS:**

(X)

If well telescopes please sketch and show depths.

GROUND LEVEL

1320'  
8" CASING

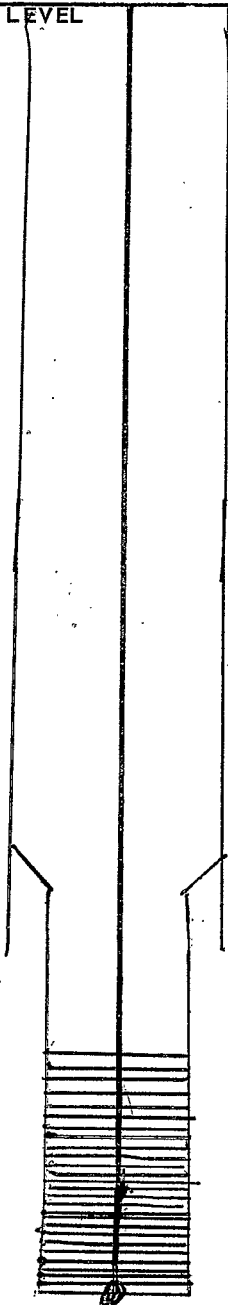

50 ft  
10/18 SS  
Screen

If more than one screen,  
show locations of each on sketch.

			X

SECTION 35

Please indicate well location X.

ADDITIONAL INFORMATION

210' Column 4"

TD of well 1457

STATIC 132

Pumping w/p 155

DD 23'

197 GPM