

OKTIBBEHA

G12

4176

FL 64

MISSISSIPPI BOARD OF WATER COMMISSIONERS 416 North State Street Jackson, Mississippi 39201

WATER WELL DRILLERS LOG

CODED

April 1976

1976

Herndon Well & Supply, Inc.

Oktibbeaha

date well completed

firm name

county well located

LANDOWNER: Talking Warrior Water Association, Inc.

Starkville, MS

(mailing address)

WELL LOCATION:

sec. 32 T 18 N R 14 E SXX XW

5 miles S of Starkville (distance) (direction) (nearest town)

WELL PURPOSE: Community (home, irrigation, municipal, industrial)

WELL COMPLETION DATA:

- (1) diameter (inches) 8
(2) total depth (feet) 1427
(3) static water level (feet) 100 below top of ground.
(4) casing Steel 1230 (material) (depth) 8 (size) if telescope see back.
(5) screen 50' (length) (depth to top) 5" Stainless Steel (size) (material)
(6) pump 20 178 (HP) (yield gpm) Elec. (type power)
(7) electric log Yes (yes or no) USGS (organization running log)
(8) how well bottom plugged

description of formations encountered

from to

Table with 3 columns: description of formations encountered, from, to. Rows include White Clay, Lime Rock, Blue Sand, Fine, Blue Clay, etc.


DRILLERS REMARKS:

RECEIVED MAY - 7 1976 MISS. Bd. OF WATER COMM

7

If well telescopes please sketch and show depths.

GROUND LEVEL

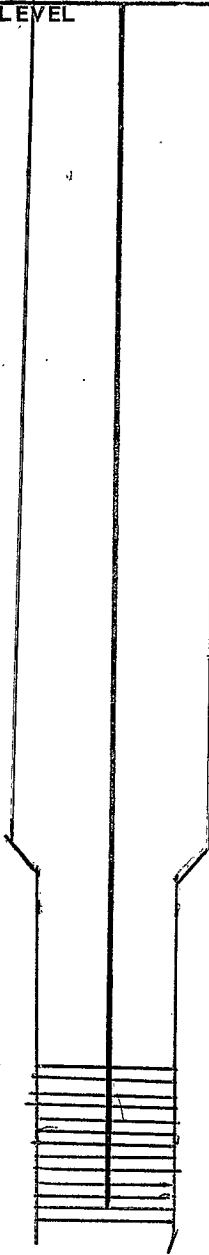

If more than one screen, show locations of each on sketch.

			X

SECTION 32

Please indicate well location X.

ADDITIONAL INFORMATION

1230' CASING 8"  
 189' COLONN 4"  
 43' CAP PIPE 5"  
 (PUMPING WL 150')  
 (STATIC WL 100')

1187' to LEAD SEAL