

Oktibbeha  
G34

136 K360  
ELOG # 42  
CODED

12-12-65 MISSISSIPPI BOARD OF WATER COMMISSIONERS  
M. G. S.

DEC - 5 1965  
CODED


WATER WELL DRILLERS LOG

Date: 12/12, 19 65, Driller: Herndon-Homan Well & Supply Co. Oktibbeha  
P. O. Box 42  
SEANOR, MISSISSIPPI 38660 (Where well is located)

(1) Owner of Land	Description & Color of Materials Sand, Clay, Red Clay, Shell, etc.	Thick- ness Feet	Depth Feet
(Name) Bluefield Community	Gray clay	0	30
(Address) WATER ASS., Stackville, Miss.	Blue clay	30	120
(2) Location: SE 1/4, 1/4, Sec. 7 T18N R14E	Sandy Blue Clay	120	150
1 miles W of Stackville	Blue clay	150	210
(distance) (direction) (Nearest Town)	Blue clay shells	210	280
(3) Topography: Flat	Blue clay w/ shells	280	300
(Hilly) (Flat) (Level)	Blue clay	300	330
(4) Purpose of Well: Community	Blue clay - hard shell	330	360
(Domestic Irrigation Municipal, Industrial, Other)	Blue clay	360	480
Information upon completion of well:	Blue clay (50 FT)	480	570
(1) Diameter 8 inches.	Sandy Blue clay	570	590
(2) Total Depth 1468 feet.	Sand & gravel	590	600
(3) Water Level 97 feet below top of ground.	Sandy Blue clay	600	640
(4) Cased to 983', Size 4"	Blue clay	640	660
(5) Screen: Size 4, Length 50'	SAND, Blue clay	660	690
(6) Were any formations sealed against pollution?	SAND, Blue clay	690	715
yes, no.	SAND rock 710-711	715	720
If YES depth of formation	Sand	720	885
Why	Blue clay	885	915
Drillers Remarks: Miss. Geo. Swasey	SAND, Blue clay	915	930
Yield in gpm: 100	SAND	930	970
Size pump: 10 HP	Rock	970	970 1/2
Type power: electric	SAND (little clay)	970 1/2	990
	Blue clay	990	1050
	SAND, Blue clay	1050	1280
	SAND	1280	1325
	Red gummy clay	1325	1340
	SAND (good)	1340	1350
	Red gummy clay	1350	1355
	SAND, Blue clay	1355	1395
	SAND	1395	1468
	Bottom		1468

Mail this copy to Board of Water Commissioners 429 Miss. St. Jackson, Miss.

⊕

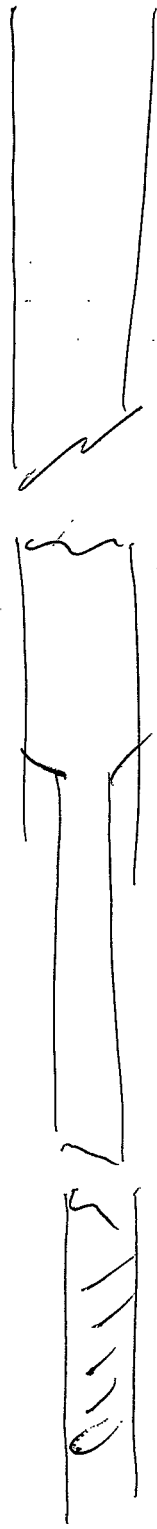

510' of 5" casing

head seal

783' of 4" casing

50' of 4" s/s screen

DWG - 5 1962

ENGR. ED. J. J.  
WATER CONTROL