

OKTIBBEHA

G 35

3-13-71

MISSISSIPPI BOARD OF WATER COMMISSIONERS
416 North State Street
Jackson, Mississippi 39201

ELOG #54

CODED

WATER WELL DRILLERS LOG

Herndon-Homan Well & Supply, Inc.

3-13

1971

date well completed

SHANNON, MISSISSIPPI 38609

county well located

LANDOWNER:	description of formations encountered	from	to
Agricultural Experiment Station, Miss.	Red Clay	0	18
State University, State College	Blue Clay	18	60
(mailing address) Miss	Blue Clay	60	612
	Sand (Streaks Shale)	612	785
WELL LOCATION:	Gummy Clay	785	1240
sec. 13 T 18 N R 14 E	Hard Rock	1240	1241
miles SE of Starkville	Gummy Clay	1241	1250
(distance) (direction) (nearest town)	Sand	1250	1315
	Shale	1315	1323
WELL PURPOSE: College & Irrigation	Sand & Pea Gravel	1323	1416
(home, irrigation, municipal, industrial)	on Bottom	1416	

WELL COMPLETION DATA:

- (1) diameter (inches) 10 x 6
- (2) total depth (feet) 1416
- (3) static water level (feet) 133 below top of ground.
- (4) casing Steel 450'
(material) (depth)
- 10"
(size) If telescope see back.
- (5) screen 60' 1293
(length) (depth to top)
- 6" Stainless Steel
(size) (material)
- (6) pump 40 401
(HP) (yield gpm)
- Electric
(type power)
- (7) electric log Yes
(yes or no)

(organization running log)

(8) how well bottom plugged B/W

CODED

APR 10 1971

DRILLERS REMARKS:

Well # G 35

MISS. BD. OF WATER COM. 1.

Ⓢ

If well telescopes please sketch and show depths.

GROUND LEVEL

450' of 10" casing


Lead Seal

843' of 6" casing

22' of Screen
21' of Blank
22' of Screen
38' of Blank

1378

If more than one screen, show locations of each on sketch.

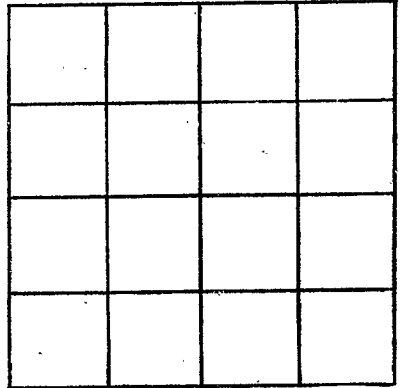

SECTION 13

Please indicate well location X.

ADDITIONAL INFORMATION

Bottom of well up

38' of Blank	bottom	1378
42' of Screen		1336
21' of Blank	↓	1315
22' of Screen	↑	1293
Top of Screen		1293